

Kansas

Map No. \_\_\_\_\_ Sec. 32 Twp. 15 R. 10W


Well No. 2 Zvolanek

Cities Service Company

Contractor

SW SE NW

SECTION PLAT

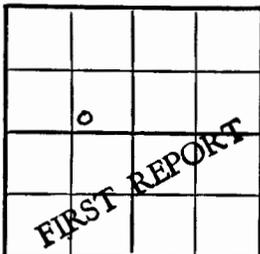

\_\_\_\_\_ Ft. from N. Line

330 Ft. from S. Line

990 Ft. from E. Line

\_\_\_\_\_ Ft. from W. Line

Ellsworth County

Location \_\_\_\_\_

Rig up \_\_\_\_\_

Drilling and Remarks:

Spud 7-29-50

8" @ 412

RECORD

Cased \_\_\_\_\_ in., \_\_\_\_\_ ft.

Sand \_\_\_\_\_

Gas \_\_\_\_\_

Oil \_\_\_\_\_

Total Depth \_\_\_\_\_

PRODUCTION

1st 24 hrs. Nat. \_\_\_\_\_

1st 24 hrs. after shot \_\_\_\_\_

Gas \_\_\_\_\_ Cu. Ft.

Dry Hole \_\_\_\_\_

Abandoned \_\_\_\_\_

Date

AUG 2 1950

19

J. E. TYRA Scout


County Ellsworth State Kansas

Sec. 32 (Blk. Twp.) 15 (Sur. Rge.) 10W Map No.

Operator Cities Service

Well No. 2 Farm Zvolanek

Elev. 1811 Location SW SE NW

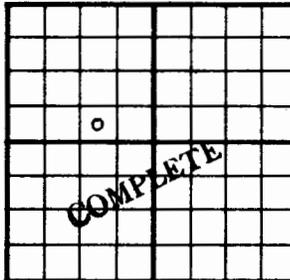

330 Ft. From S Line NW

990 Ft. From E Line Quarter

1st. Report ~~SEP 20 1950~~

Completion SEP 20 1950

Remarks

Stoltenberg Pool

Spudding Date 7-29-50

Drig. Data Oil well TD 3296

8" @ 412 Lans. 2957 Arb. 3285

TD 3287 5" @ 3286 DD 3296 FU 1200'

oil in 5 hr. 2700' oil in 15 hr.

Comp. 176 bopd

J. E. TYRA

Sec. 32 Twp. 15 R. 10-W

Well No. #2 Zvolanek Farm

Cities Service Company

Contractor

Stoltenberg


\_\_\_\_\_ Ft. from N. Line

330 Ft. from S. Line

990 Ft. from E. Line

\_\_\_\_\_ Ft. from W. Line

SW SE NW

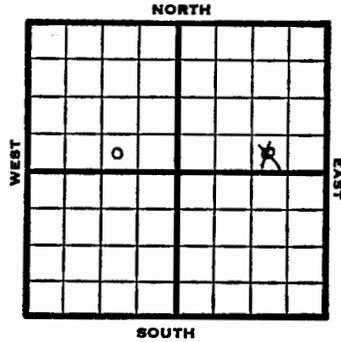


Section 32 Township 15 Range 10-W

Well No. #2 Zvolanek

Company Cities Service

NORTH

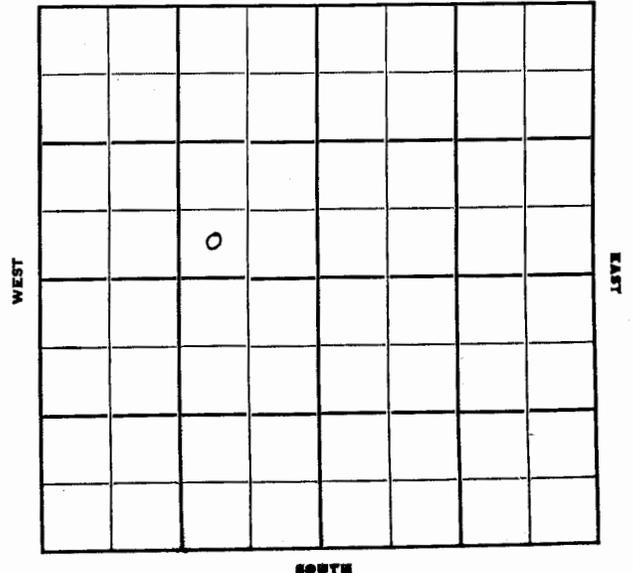

1950 Elev 1811 REPORT

8/2 Spud 7-29-50

8" @ 412

9/20 8" @ 412

Lans 2957

Arb 3285

TD 3287

5" @ 3286

D 3296 FU 1200'

oil in 5 hr 2700' oil in 15 hr

Comp. 176 bopd

Completed

COMPLETED

TD 3296