

KANSAS / Kansas Pool Name Vacek

Map No. 55 Sec. 32 Twp. 15 R. 10W

Well No. 1 Zvolaneka

Cities Service Company

FIRST REPORT Contractor

NE SE NW

SECTION PLAT

_____ Ft. from N. Line

990 Ft. from S. Line

330 Ft. from E. Line

_____ Ft. from W. Line

Ellsworth County

Location X

RECORD

Cased _____ in., _____ ft.

Sand _____

Gas _____

Oil _____

Total Depth _____

PRODUCTION

1st 24 hrs. Nat. _____

1st 24 hrs. after shot _____

Gas _____ Cu. Ft.

Dry Hole _____

Abandoned _____

Date

FEB 20 1946 19 _____ S. J. LEWIS Scout

KANSAS / Kansas Pool Name Vacek

Map No. 55 Sec. 32 Twp. 15 R. 10W

Well No. 1 Zvolaneka

Cities Service Company

COMPLETED Contractor

NE SE NW

SECTION PLAT

_____ Ft. from N. Line

990 Ft. from S. Line

330 Ft. from E. Line

_____ Ft. from W. Line

Ellsworth County

Location _____

RECORD

Cased _____ in., _____ ft.

Sand _____

Gas _____

Oil _____

Total Depth 3294

PRODUCTION

1st 24 hrs. Nat. _____

1st 24 hrs. after shot _____

Gas _____ Cu. Ft.

Dry Hole _____

Abandoned _____

Date

JUN 12 1946 19 _____ S. J. LEWIS Scout

KANSAS Ellsworth County

Sec. 32 Twp. 15 R. 10W

Well No. #1 Zvolaneka Farm


Cities Service Company

Vacek
 _____ Ft. from N. Line

990 _____ Ft. from S. Line

330 _____ Ft. from E. Line

_____ Ft. from W. Line

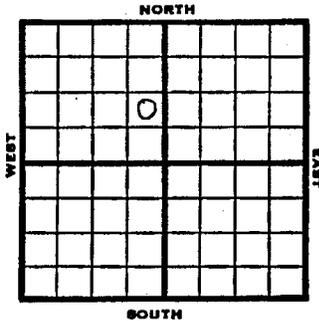

NE SE NW

1946

6/14 Arb 3286'
 4" @ 3289'
 Pump 78 oil 24 W Pot.
 33.0 Gr
 TD 3294'

COMPLETED

1946	Elev 1798' REPORT
2/20	Location
2/28	"
3/7	8" - 405' WOC.
3/14	Drlg. 2150'
3/21	Topeka 2610' Lans. 2945' SO Drlg. 3201'
3/28	Arb. 3291-97' T.D. Sat. 4" - 3294' RUST.
4/4	" " "
4/10	2600' oil in 9 hrs.
4/16	Arb 3286 Corrected 4" @ 3289 TD 3294 Swb 186 oil in 19 hrs
4/23	" " "
5/1	Pump 2370 fluid 24 hrs 9% wtr
5/7	Fsg.
5/14	PB 3292'
5/21	Pump 29 oil 4 W in 6 hrs.
5/29	" " " "
6/5	Pump 59 oil plus 12 W. in 18 hrs.

OVER

Section 32 Township 15 Range 10-~~W~~

Well No. #1 Zvolaneka

Company Cities Service

