



Ellsworth

KANSAS


SEC. 32	TWP. 15	R. 10W
---------	---------	--------

WELL NO. 1 Zvolanek FARM

COMPANY Henderson Oil

CONTRACTOR Garvey

Wildcat  
 330' Ft. from N. Line  
 Ft. from S. Line  
 330' Ft. from E. Line  
 Ft. from W. Line

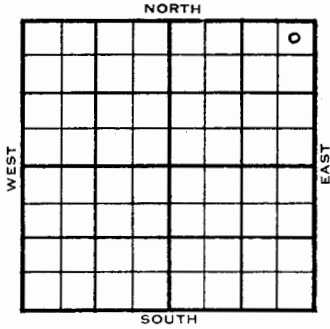

NE NE NE  
 CSO - Support

1955	ELEVATION	REPORT
------	-----------	--------

5/25	Location	
6/29	Comm. 6-14-55	
	8 5/8" @ 360/230 D&A	
	Tops: Depth	Datum
	H. 2826	1047
	Dg. 2856	1077
	BL. 2928	1149
	L. 2942	1163
	C. 3275	1496
	A. 3336	1557
	TD. 3375	

**ABANDONED**

DX-78

DX 78-1 Ellsworth KANSAS

Section 32 Township 15 Range 10W

Well No. #1 Zvolanek

Company Henderson Oil

