

County Ellsworth State Kansas
 Sec. 32 (Blk. Twp.) 15 (Sur. Rge.) 10W Map No.
 Operator Cities Service Oil
 Well No. 5 Farm Back VACEK
 Elev. _____ Location SE NW SW

FIRST REPORT

990 Ft. From N Line SW
 990 Ft. From W Line Quarter
 1st. Report JUL 23 1952
 Completion _____
 Remarks _____
Lohman & Johnson - Contr
 Spudding Date 7-17-52

Drig. Data

10" @ 438 drlg. 2065

J. G. McGEHEE

County Ellsworth State Kansas
 Sec. 32 (Blk. Twp.) 15 (Sur. Rge.) 10W Map No.
 Operator Cities Service Oil
 Well No. 5 Farm Back VACEK
 Elev. 1787 Location SE NW SW

COMPLETE

990 Ft. From N Line SW
 990 Ft. From W Line Quarter
 1st. Report _____
 Completion AUG 6 1952
 Remarks _____
Lohman & Johnson - Contr.
 Spudding Date 7-17-52

Drig. Data Oil well TD 3267

10" @ 438 Heeb. 2820 Dodge 2850Lans. 2939 Arb. 3254 TD 3255 7" @ 3255DD 3267 2 1/2 boph 9 hr. 1500 AComp. 115 bopd 6 bw

J. G. McGEHEE

Ellsworth KANSAS ✓

Sec. 32 Twp. 15 R. 10 W

Well No. # 5 Bacek VACEK Farm

Cities Service Oil Company

Lohman & Johnson Contractor


990 Ft. from N. Line

Ft. from S. Line

Ft. from E. Line

990 Ft. from W. Line

SE NW SW

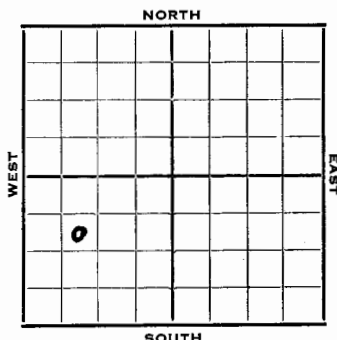


KANSAS

Section 32 Township 15 Range 10W

Well No. #5 Bacek VACEK

Company Cities Service Oil

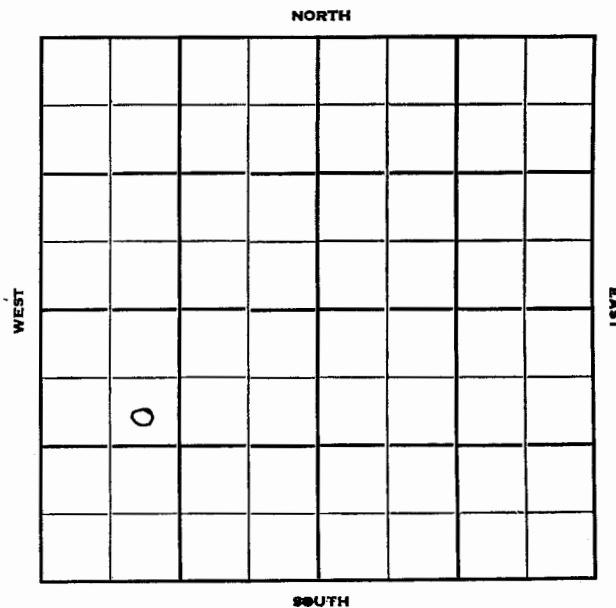

1952

Elev. 1787' REPORT

7/23

Spud 7-17-52

10" @ 438'

Drlg. 2065'

7/30

Heeb 2820' Dodge 2850' Lans. 2939'

Arb. 3254' RTD 3255' 7" @ 3255'

8/6

Spud 7-17-52

Oil well TD 3267' 10" @ 438'

Heeb 2820' Dodge 2850' Lans. 2939'

Arb. 3254' TD 3255' 7" @ 3255'

DD 3267 2 1/2 BOPH 9 hr. 1500 A

Comp. 115 BOPD 6 BW

COMPLETED