

Kansas

Map No. _____ Sec. 32 Twp. 15 R. 10W

Well No. 3 Back VACEK

C. S. O. _____ Company

Contractor

SE SW SW

SECTION PLAT

_____ Ft. from N. Line

330 Ft. from S. Line

_____ Ft. from E. Line

990 Ft. from W. Line



Ellsworth

Location X

Rig up

Drilling and Remarks:

RECORD

Cased _____ in., _____ ft.

Sand _____

Gas _____

Oil _____

Total Depth _____

PRODUCTION

1st 24 hrs. Nat. _____

1st 24 hrs. after shot _____

Gas _____ Cu. Ft.

Dry Hole _____

Abandoned _____

Date

MAY 17 1950

19

J. E. TYRA

Scout

Kansas

Map No. _____ Sec. 32 Twp. 15 R. 10W

Well No. 3 Back VACEK

C. S. O. _____ Company

Contractor

SE SW SW

E1.1826


SECTION PLAT

330 Ft. from N. Line

_____ Ft. from S. Line

990 Ft. from E. Line

_____ Ft. from W. Line

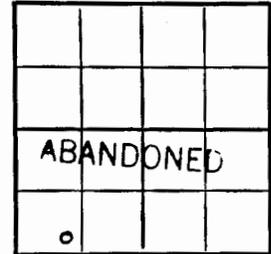

Ellsworth

Location _____

Rig up _____

Drilling and Remarks:

8" @ 442
 Lens 2971
 Log 3296
 Simp sd 3314
 Arb 3328
 D + A

RECORD

Cased _____ in., _____ ft.

Sand _____

Gas _____

Oil _____

Total Depth 3362

PRODUCTION

1st 24 hrs. Nat. _____

1st 24 hrs. after shot _____

Gas _____ Cu. Ft.

Dry Hole _____

Abandoned _____

Date

JUN 7 1950

19

J. E. TYRA

Scout

Sec. 32 Twp. 15 R. 10W

Well No. #3 Beek VACEK Farm _____

C.S. O. Company _____

Contractor _____


_____ Ft. from N. Line

330' Ft. from S. Line

_____ Ft. from E. Line

990' Ft. from W. Line


SE SW SW

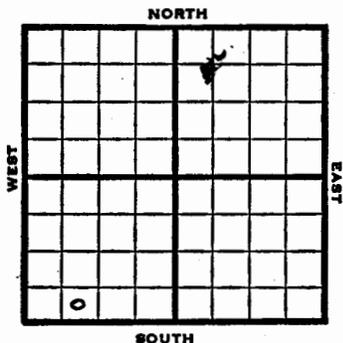

Section 32 Township 15 Range 10-W

Well No. #3 Beek VACEK

Company _____

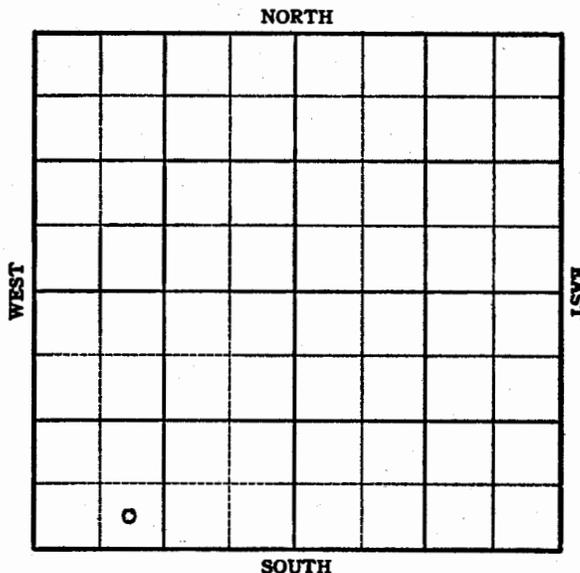

1950

Elev.

REPORT

5/17

Location

6/7

8" @ 442'

Lans. 2971'

Cong 3296'

Simp. Sd 3314'

Arb 3328'

TD 3362'

D&A

ABANDONED