

Kansas

Map No. _____ Sec. 32 Twp. 15 R. 10W
 Well No. 2 ~~Back~~ VACEK

Cities Service _____ Company

Lohman & Johnson _____ Contractor

SW NE SW

SECTION PLAT



990 Ft. from N. Line

Ft. from S. Line

990 Ft. from E. Line

Ft. from W. Line

Ellsworth County

Location _____

Rig up _____

Drilling and Remarks:

Cellar & pits

RECORD

Cased _____ in., _____ ft.

Sand _____

Gas _____

Oil _____

Total Depth _____

PRODUCTION

1st 24 hrs. Nat. _____

1st 24 hrs. after shot _____

Gas _____ Cu. Ft.

Dry Hole _____

Abandoned _____

Date

MAR 1

1950

19

J. E. TYRA

Scout

Kansas


Map No. _____ Sec. 32 Twp. 15 R. 10W
 Well No. 2 ~~Back~~ VACEK

Cities Service _____ Company

Contractor

SW NE SW

EI. 1817
SECTION PLAT

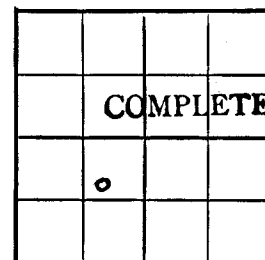

990 Ft. from N. Line

Ft. from S. Line

990 Ft. from E. Line

Ft. from W. Line

Ellsworth County

Location _____

Rig up _____

Drilling and Remarks:

8" @ 426
 Sand 2945
 Limp 3267
 and 3287
 5" @ 3287
 123 BOPD

RECORD

Cased _____ in., _____ ft.

Sand _____

Gas _____

Oil _____

Total Depth 3293

PRODUCTION

1st 24 hrs. Nat. _____

1st 24 hrs. after shot _____

Gas _____ Cu. Ft.

Dry Hole _____

Abandoned _____

Date

APR 12 1950

19

J. E. TYRA Scout

KANSAS
Ellsworth 10W ✓

Sec. 32 Twp. 15 R. 10W

Well No. #2 Bacek VACEK Farm

Cities Service Company

Lohman & Johnson Contractor


990' Ft. from N. Line

Ft. from S. Line

990' Ft. from E. Line

Ft. from W. Line

SW NE SW

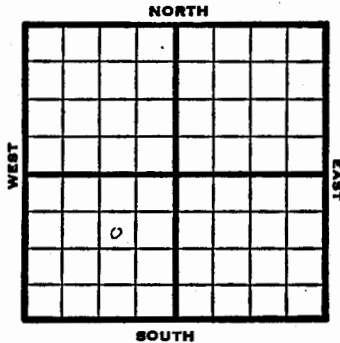

1950 Elev 1817' REPORT

3/1 Cellar & Pits

4/12 TD 3293'

8" @ 426'

Lans 2945'

Simp 3267'

Arb. 3287'

5" @ 3287'

123 BOPD

Comp

COMPLETED

KANSAS Ellsworth

Section 32 Township 15 Range 10-W

Well No. #2 Bacek VACEK

Company Cities Service

