

Ellsworth

KANSAS

Sec. 32 Twp. 15 R. 10W

Well No. #1 Vacek Farm

R. J. Shields Company

Contractor


990' Ft. from N. Line

Ft. from S. Line

Ft. from E. Line

330' Ft. from W. Line

SW NW SE

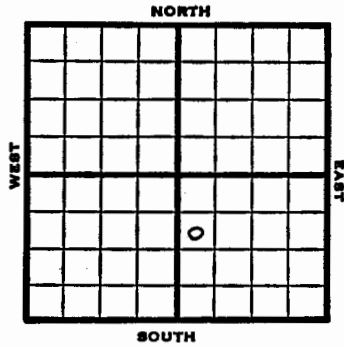


Ellsworth KANSAS

Section 32 Township 15 Range 10W

Well No. #1 Vacek

Company R.J. Shields

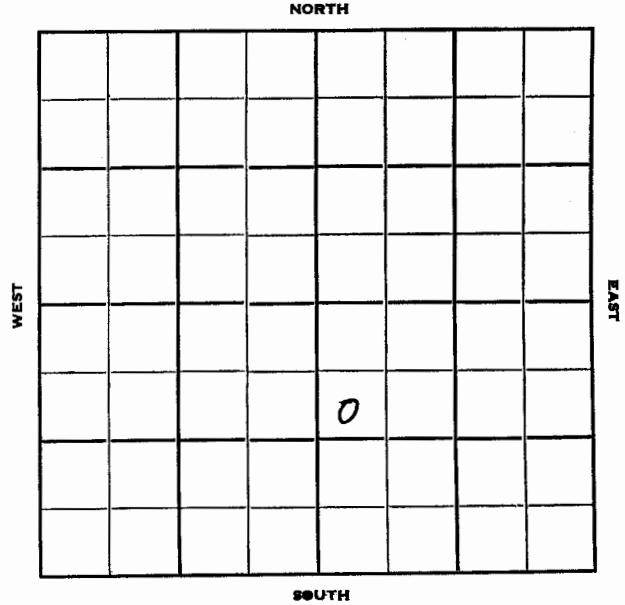

1951 Elev. 1785' REPORT

1/3 Location

4/4 Spud 1-3-51
Oil well TD 3295'
12" @ 425' Anhy 635' 10" @ 600'
8" @ 1883' 7" @ 2795'
Heeb 2828' Lans. 2934' 5" @ 3244'
Arb. 3291' TD 3295' S/ 52 BOPD
Comp. 55 BOPD

COMPLETED