

County **Ellsworth** Elev. _____
 Sec. **33** Twp. **15** Rgs. **10W**
 Company **Jones, Shelburne & Farmer**
 FarmName **Yusta** No. **1**

County **Ellsworth** Elev. **1744**
 Sec. **33** Twp. **15** Rgs. **10W**
 Company **Jones, Shelburne & Farmer**
 FarmName **Yusta** No. **1**

TOPS	DEPTH	LOG	DATUM	Loc. in Sec.
Anh.				SE SE SE
Tp.				
H.				
Tr.				
Dg.				
Bl.				
L.				
K.C.				Geol. _____
B.K.C.				Contr. _____
Ce.				Co. tools
C.				
M.				Pool _____
K.				NW Progress
Mz.				
Me.				
V.				
S.				
A.				
R.				
Pe.				
G.				
Tp.				

TOPS	DEPTH	LOG	DATUM	Loc. in Sec.
Anh.				SE SE SE
Tp.				
H.	2773		1029	
Tr.	2790		1046	
Dg.	2861		1057	
Bl.	2872		1128	
L.	2892		1148	
K.C.				Geol. _____
B.K.C.				Contr. _____
Ce.				Co. tools
C.	3219		1475	
M.				Pool _____
K.				NW Progress
Mz.				
Me.				
V.				
S.				
A.	3293		1549	
R.				
Pe.				
G.				
Tp.	3297			

AUG 24 1955
FIRST REPORT

COMPLETE

Date Comm. **8-22-55**
8" @ 165/125 WOC

Date Comm. **8-22-55** **NOV 9 1955**
8" @ 165/125 surface parted @ 2800

skid ric spud 8-29-55 8 5/8" @ 275/250
 BST 3294-97 open 1 hr. rec. 2400' oil
 1110/20" 5" @ 3294/75 GO to 3297
 S/ 35 boph Comp. 205 bopd 4 3/4 tr.

Ellsworth

KANSAS


SEC.	33	TWP.	15	R.	10W
------	----	------	----	----	-----

WELL NO. #1 Yusta FARM

COMPANY Jones, Shelburne & Farmer

CONTRACTOR Co. Tools
NW Progress

_____ Ft. from N. Line
 _____ Ft. from S. Line
 _____ Ft. from E. Line
 _____ Ft. from W. Line

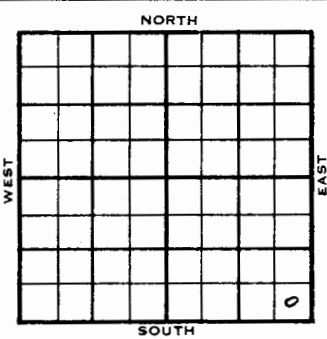

SE SE SE

	ELEVATION	REPORT
1955	1744	

8/24 Comm 8-22-55
8" @ 165/125 WOC

11/79 Comm 8-22-55
8" @ 165/125
 H 2773
 Tr 2790
 Dg 2801
 Bl 2972
 L 2892
 C 3219
 A 3293
 TD 3297
 surface parted @ 2800
 skid rig Spud 8-29-55 8 5/8" @ 275/
 250 DST 3294-97 open 1 hr rec
 2400' oil 1110/20" 5 1/2" @ 3294/75
 CO to 3297 S/35 boph
 Comp 205 bopd 4% wtr

COMPLETED

DX-78

DX 78-1

Ellsworth

KANSAS

Section 33 Township 15 Range 10 W

Well No. #1 Yusta

Company Jones, Shelburne & Farmer

