

Ellsworth

KANSAS

Ellsworth KANSAS

SEC. 33 TWP. 15 R. 10W

SECTION 33 TOWNSHIP 15 RANGE 10 W

WELL NO. #1 Sebesta FARM

WELL NO. #1 Sebesta

COMPANY Harry D. Thompson & M. F. Bear

COMPANY Harry D. Thompson & M. F. Bear

CONTRACTOR Lewis Drlg Co.


NW Progress

Ft. from N. Line

Ft. from S. Line

Ft. from E. Line

Ft. from W. Line

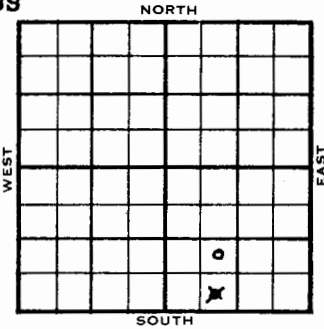

NE
SE SW SE

	ELEVATION	REPORT
1955	1742	
10/26	Loc	
11/9	Comm 10-30-55 8 5/8" @ 313/200 H 2791 Dg 2821 BL 2892 L 2912 BKC 3210 Marm 3229 C 3251 TD 3415 D & A	

ABANDONED

