

County Ellsworth Elev. _____

Sec. 34 Twp. 15 Rge. 10W

Company O & C Pet.

Farm Name Zamora No. 1

TOPS	DEPTH	LOG	DATUM	Loc. in Sec.
Anb.				SW SW NW
Tr.				
H.				
Tr.				
Dg.				
Bl.				
L.				Geol.
K.C.				
B.K.C.				Contr.
Ce.				Harms & Burt
C.				
M.				Pool
K.				Wildcat
Mz.				
Me.				
V.				
S.				
A.				
R.				
Pe.				
G.				
TD.				

Date Comm. WOR

OCT 5 '53

FIRST REPORT

County	Ellsworth	Elev.	1705
Sec.	34	Twp.	15
		Rge.	10W
Company	C & C Pet.		
Farm Name	Zamrzla	No.	1

TOPS	DEPTH	LOG	DATUM	Loc. in Sec.
Anh.	497			SW SW NW
Tr.				
H.	2736		1031	
Tr.				
Dg.				
Bl.	2842		1137	
L.	2855		1150	
K.C.				Geol.
B.K.C.				Contr.
Ce.				
C.	chest	3191	1486	Harms & Bur
M.				Pool
M.				
K.				Wildcat
Mz.				
Me.				
V.				
S.	3219		1514	
S.				
A.	3283		1578	
R.				
Pe.				
G.				
TD.	3298			

OCT 19 1955

8 5/8" @ 280/200 DST 2864-2901

open 1 hr. Rec. 90' vso spkd mud

1325/20"

D & A

Ellsworth KANSAS

SEC.	TWP.	R.
34	15	10W

WELL NO. #1 Zamrzla FARM

COMPANY C & C Pet

CONTRACTOR Harms & Burt
Wildcat


Ft. from N. Line

Ft. from S. Line

Ft. from E. Line

Ft. from W. Line

SW SW NW

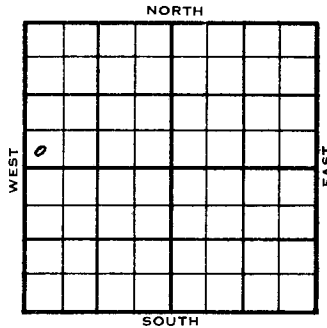

	ELEVATION	REPORT
1955	1705'	
10/5	WOR	
10/19	Comm 10-3-55 8 5/8" @ 280/200 Anh 497 H 2736 B1 2842 L 2855 Chert 3191 S 3219 A 3283 TD 3298 DST 2864-2981 open 1 hr Rec 90' vso spkd mud 1325/20" D & A ABANDONED	

DX-78

DX 78-1

Ellsworth KANSAS

Section 34 Township 15 Range 10 W

Well No. #1 Zamrzla

Company C&C Pet.

