

27-15-11W

KANSAS GEOLOGICAL SOCIETY
KANSAS WELL LOG BUREAU - KANSAS WELL SAMPLE BUREAU
KANSAS GEOLOGICAL SOCIETY BUILDING
508 EAST MURDOCK - WICHITA, KANSAS

COMPANY DUKE DRILLING

SEC. 27 T. 15 R. 11W
 LOG. SE SW SE

FARM Heard

NO. 2

COUNTY Russell

TOTAL DEPTH 3356'

COMM. 12-4-67

COMP. 12-11-67



SHOT OR TREATED

CONTRACTOR Duke Drilling

ISSUED 1-20-68

CASING

20 10
 15 8 5/8" 541' cem w/ 250 sx
 12 6
 13 5

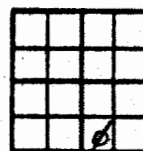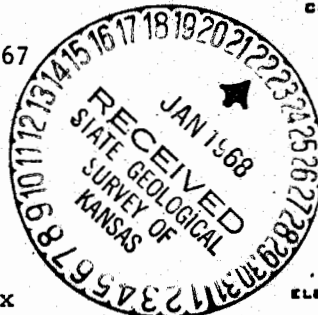

ELEVATION 1856' KB

PRODUCTION DRY/ CONG

FIGURES INDICATE BOTTOM OF FORMATIONS

Russell Co., Ks.

ELEVATION: 1856 K.B.

0 -	50	Clay - Postrock
50 -	320	Sand - Shale
320 -	530	Shale
530 -	717	Red Bed
717 -	742	Anhydrite
742 -	1400	Red Bed shale Shells
1400 -	1650	Shale & lime
1650 -	1845	Lime Shale
1845 -	2545	Shale & Lime
2545 -	2898	Lime
2898 -	2902	Shale
2902 -	2916	Lime Shale
2916 -	2927	Lime
2927 -	3000	Shale Sand
3000 -	3004	Brown Lime
3004 -	3292	Lime
3292 -	3356	Conglomerate

FORMATION DATA

Anhydrite	717
Heebner	2898
Brown Lime	2990
Lansing	3004
Conglomerate	3292
RTD	3356

OPS: LOG

Anhydrite	716
Heebner	2898
Toronto	2916
glas	2927
own lime	2990
Lansing	3006
Marmaton	3256
Shaley Conglomerate	3294
Sandy Conglomerate	3324
Arbuckle	none

SURFACE PIPE: Set
 8-5/8" at 541' with 250
 sacks cement.

AFFIDAVIT

STATE OF KANSAS
 COUNTY OF BARTON)ss.

L. O. Chubb, of lawful age, does swear that the facts and
 statements herein contained are true and correct to the best of his
 knowledge.