

Map No. 55 Sec. 12 Twp. 15 R. 11WWell No. 1 Davidson

Pryor & Lockhart et al Company

Contractor

FIRST REPORT

C E L NE NW

660 Ft. from N. Line

Ft. from S. Line

330 Ft. from E. Line

Ft. from W. Line

WILDCAT

SECTION PLAT

Location

RECORD

Cased _____ in., _____ ft.

Sand _____

Gas _____

Oil _____

Total Depth _____

PRODUCTION

1st 24 hrs. Nat. _____

1st 24 hrs. after shot _____

Gas _____ Cu. Ft.

Dry Hole _____

Abandoned _____

Date

JUN 5 1940 19

S. J. LEWIS

Scout

Map No. 55 Sec. 12 Twp. 15 R. 11WWell No. 1 Davidson

Pryor & Lockhart et al Company

Contractor

ABANDONED

C E L NE NW

660 Ft. from N. Line

Ft. from S. Line

330 Ft. from E. Line

Ft. from W. Line

WILDCAT

SECTION PLAT

Location

RECORD

Cased _____ in., _____ ft.

Sand _____

Gas _____

Oil _____

Total Depth 3321

PRODUCTION

1st 24 hrs. Nat. _____

1st 24 hrs. after shot _____

Gas _____ Cu. Ft.

Dry Hole _____

Abandoned _____

Date

AUG 21 1940 19

S. J. LEWIS Scout

KANSAS

Russell

Sec. 12 Twp. 15 R. 11-WWell No. #1 Davidson FarmPryor & Lockhart et al Company

(Wildcat)


660 Ft. from N. Line

Ft. from S. Line

330 Ft. from E. Line

Ft. from W. Line

Elev. 1765

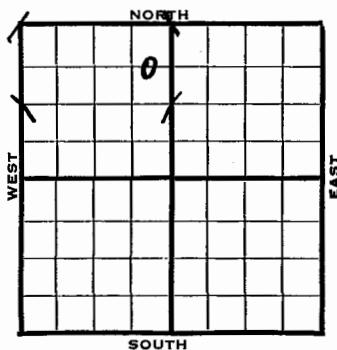

1940	REPORT
6/5	Cable.
6/13	Rigging up.
6/20	15" - 312' Drlg. 405'
6/27	13" - 525' Drlg.
7/3	13" - 624' Drlg. 1235'
7/11	Ft. Riley 1514' 10" - 1913'
	1955' U.R. 10".
7/18	10" - 1940' Drlg. 2585'
7/25	Lans. 2930' 8" - 2940' C.O.
8/2	Fsg. 3195'
8/8	" "
8/14	3220 U.R. 7"
8/21	Arb. 3309'
	T.D. 3321'
	H.F.W.
	ABANDONED

KANSAS
Form 51-5M-7-39-Palace

Russell

Section 12 Township 15 Range 11-WWell No. #1 DavidsonCompany Pryor & Lockhart et al