


County Russell State Kansas
 Sec. 13 (Blk. Twp.) 15 (Sur. Rge.) 11W Map No.
 Operator Shelly-Miller
 Well No. 1 Farm Hoch
 Elev. 1792 Location SW SW SE

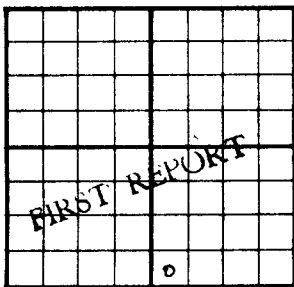


330 Ft. From S Line SE
330 Ft. From W Line Quarter
 1st. Report JUL 14 1954
 Completion
 Remarks
Shelly-Miller - Contr.
 Spudding Date 7-10-54

Drig. Data Wildcat
8" @ 282 Anhy 646 drlg. 1367

J. G. McGEHEE

County Russell State Kansas
 Sec. 13 (Blk. Twp.) 15 (Sur. Rge.) 11W Map No.
 Operator Shelly-Miller
 Well No. 1 Farm Hoch
 Elev. 1792 Location SW SW SE

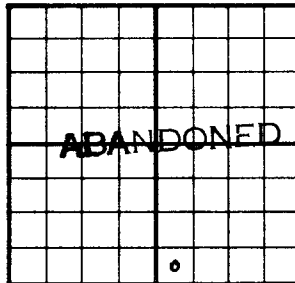

330 Ft. From S Line SE
330 Ft. From W Line Quarter
 1st. Report
 Completion JUL 21 1954
 Remarks Wildcat
Shelly-Miller - Contr.
 Spudding Date 7-10-54

Drig. Data D & A TD 3325
8" @ 282 Anhy 646 Heeb. 2845
Br. lime 2941 Lans. 2955 Cong. 3301
DST 3280-3310 open 1 hr. Rec. 1975' wtr.
980# TD 3325

D & A

J. G. McGEHEE

Russell KANSAS

SEC.	TWP.	R.
13	15	11W

WELL NO.

1 Hoch

FARM

COMPANY

Shelly-Miller

CONTRACTOR

Shelly Miller

Wildcat

Ft. from N. Line

330


Ft. from S. Line

Ft. from E. Line

330

Ft. from W. Line

SW SW SE

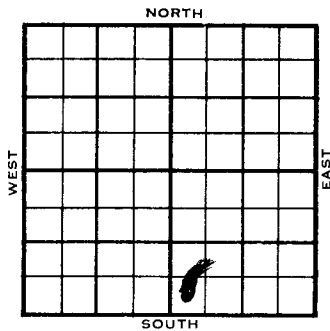

	ELEVATION	REPORT
1954	1792	

14/7 Spdg 7-10-54
8" @ 282
Anhy 646
Drlg. 1367

7/21 Spdg 7-10-54
D&A
TD 3325
8" @ 282
Anhy 646 Heeb 2845 Brlm 2941
Lans. 2955 Cong. 3301
DST 3280-3310 open 1 hr. Rec. 1975'
wtr. 980#
TD 3325
D&A

ABANDONED

2146
1792
1367
3301
1792
1367-2610

Russell KANSAS

DX 78-1

Section 13 Township 15 Range 11WWell No. 1 HochCompany Shelly- Miller