

Map No. 53 Sec. 18 Twp. 15 R. 11W

Well No. 1 Frederick

Empire Company

Contractor

SECTION PLAT

_____ Ft. from N. Line

330 Ft. from S. Line

380 Ft. from E. Line

_____ Ft. from W. Line

NO RECORD

Location _____

Rig up _____

Drilling and Remarks:
R.D.G.

RECORD

Cased _____ in., _____ ft.

Sand _____

Gas _____

Oil _____

Total Depth _____

PRODUCTION

1st 24 hrs. Nat. _____

1st 24 hrs. after shot _____

Gas _____ Cu. Ft.

Dry Hole _____

Abandoned _____

Date NOV 10 1936 19 _____

S. J. LEWIS Scout

Map No. 53 Sec. 18 Twp. 15 R. 11W

Well No. 1 Frederick

Empire Company

Contractor

SECTION PLAT

_____ Ft. from N. Line

330 Ft. from S. Line

330 Ft. from E. Line

_____ Ft. from W. Line

ABANDONED

Location _____

Rig up _____

Drilling and Remarks:
Sil 3394
HPW.
JYH

RECORD

Cased _____ in., _____ ft.

Sand _____

Gas _____

Oil _____

Total Depth 3401

PRODUCTION

1st 24 hrs. Nat. _____

1st 24 hrs. after shot _____

Gas _____ Cu. Ft.

Dry Hole _____

Abandoned _____


Date JAN 20 1937 19 _____

S. J. LEWIS Scout

Sec. 18 Twp. 15 R. 11-W

Well No. 1 Fredrick Farm

Empire Company

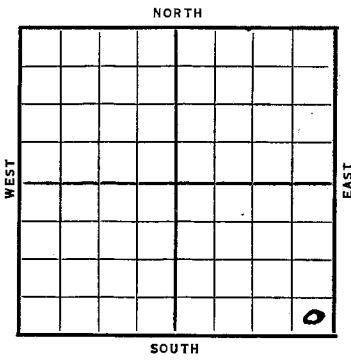

_____ Ft. from N. Line

330 Ft. from S. Line

330 Ft. from E. Line

_____ Ft. from W. Line

Elev. 1858

1986 REPORT

11/10 R. O. G.
 11/19 Rigging up
 11/27 20" @ 30'. Drlg. 385'.
 12/3 15" @ 472'. Drlg. 700'.
 12/10 12" @ 1134'. Drlg. 1240'.
 12/17 10" @ 2047'. Drlg. 2180'.
 12/24 8" @ 2575'. Drlg. 2640'.
 12/29 Topeka 2700'. Lansing 3034'.
 Drlg. 3035'.

1937

1/7 5" @ 3295' Drlg.
 1/14 5" @ 3296'. Conglomerate 3335
 Sil. 3391'. T. D. 3395'.
 Underream 5".

1/20 Sil. 3394'. T. D. 3401'.
 H. F. W.

ABANDONED

Section 18 Township 15 Range 11W

Well Number 1 Fredrick

Company Empire

