


KANSAS 55 Pool Name Chegwidden
Map No. 55 Sec. 20 Twp. 15 R. 11W

Well No. 1 Daniels
Beardmore Drlg. Company

FIRST REPORT Contractor

SW SE

SECTION PLAT

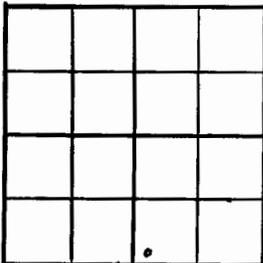

330 Ft. from N. Line
330 Ft. from S. Line
330 Ft. from E. Line
330 Ft. from W. Line

Russell County

Location _____

Rig up _____

Drilling and Remarks:

10" - 240
1640

RECORD

Cased _____ in, _____ ft.
Sand _____
Gas _____
Oil _____
Total Depth _____

PRODUCTION

1st 24 hrs. Nat. _____
1st 24 hrs. after shot _____
Gas _____ Cu. Ft.
Dry Hole _____
Abandoned _____

Date

MAY 3 1 1944 19 S. J. LEWIS Scout


KANSAS Pool Name Chegwidden
Map No. 55 Sec. 20 Twp. 15 R. 11W

Well No. 1 Daniels
Beardmore Drlg. Company

ABANDONED Contractor

SW SE

SECTION PLAT

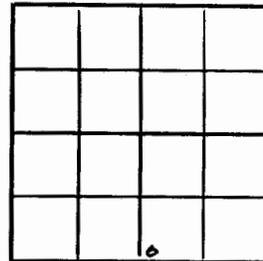

330 Ft. from N. Line
330 Ft. from S. Line
330 Ft. from E. Line
330 Ft. from W. Line

Russell County

Location _____

Rig up _____

Drilling and Remarks:

Top 2 ka 2689
Line 2980
Comp 3255
CEY 3312

RECORD

Cased _____ in, _____ ft.
Sand _____
Gas _____
Oil _____
Total Depth 3926

PRODUCTION

1st 24 hrs. Nat. _____
1st 24 hrs. after shot _____
Gas _____ Cu. Ft.
Dry Hole _____
Abandoned _____

Date

JUN 7 1944 19 S. J. LEWIS Scout

KANSAS

Russell


Sec. 20 Twp. 15 R. 11W

Well No. #1, Daniels Farm

Beardmore Drlg. Company

Chegwidden

NORTH

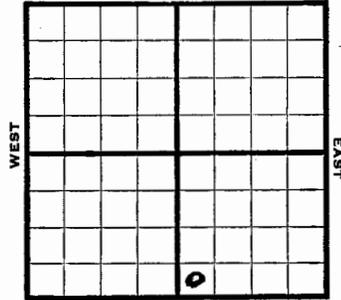

_____ Ft. from N. Line

330 Ft. from S. Line

_____ Ft. from E. Line

330 Ft. from W. Line

1944

REPORT

5/31 10" at 240'
Drlg. 1640'

6/7 Topeka 2639
Lans 2980
Cong. 3285
Arb. 3312
TD 3326

ABANDONED

KANSAS


Russell

Section 20 Township 15 Range 11W

Well No. #1, Daniels

Company Beardmore Drlg. Co.

NORTH

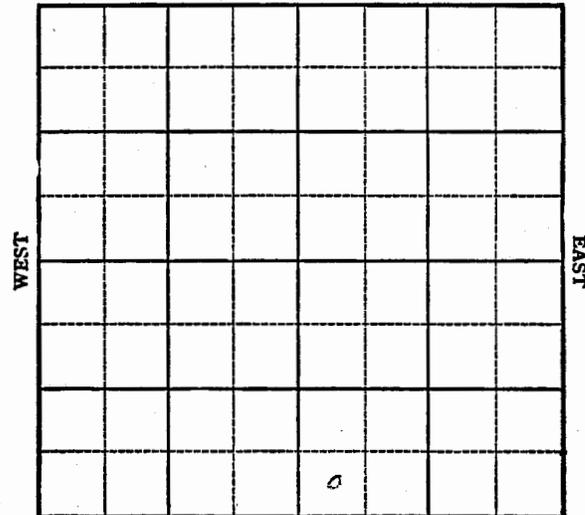

SOUTH