

Map No. 1 Sec. 22 Twp. 15 R. 11WWell No. 1E. I. Thompson Company
Contractor

SECTION PLAT

660 Ft. from N. Line

----- Ft. from S. Line

----- Ft. from E. Line

660 Ft. from W. Line

		0	

FIRST REPORTS

Location -----

Rig up -----

Drilling and Remarks:

Location
3500 ft. & tried
No gain name
reported.

RECORD

Cased ----- in., ----- ft.

Sand -----

Gas -----

Oil -----

Total Depth -----

PRODUCTION

1st 24 hrs. Nat. -----

1st 24 hrs. after shot -----

Gas ----- Cu. Ft.

Dry Hole -----

Abandoned -----

Date

OCT 20 1926

S. J. LEWIS

Scout

Map No. 1 Sec. 22 Twp. 15 R. 11WWell No. 1Streeter & Sterns Company
Contractor

SECTION PLAT

660 Ft. from N. Line

----- Ft. from S. Line

----- Ft. from E. Line

660 Ft. from W. Line

		0	

Correction

Location -----

Rig up -----

Drilling and Remarks:

Streeter & Sterns
have taken
this over from
E. I. Thompson

RECORD

Cased ----- in., ----- ft.

Sand -----

Gas -----

Oil -----

Total Depth -----

PRODUCTION

1st 24 hrs. Nat. -----

1st 24 hrs. after shot -----

Gas ----- Cu. Ft.

Dry Hole -----

Abandoned -----

Date

DEC 1 - 1926

S. J. LEWIS

Scout

MAP No. _____ SEC. 22 TWP. 15S R. 11WWELL No. 1 LilakE. J. Thompson COMPANY

CONTRACTOR

SECTION PLAT

		0	

_____ Ft. FROM N. LINE

_____ Ft. FROM S. LINE

_____ Ft. FROM E. LINE

_____ Ft. FROM W. LINE

LOCATION _____

RIG UP _____

DRILLING AND REMARKS:

RECORD

CASED _____ IN. _____ FT.

SAND _____

GAS _____

OIL _____

TOTAL DEPTH 3200

PRODUCTION

1ST 24 HRS. NAT. _____

1ST 24 HRS. AFTER SHOT _____

GAS _____ Cu. Ft.

DRY HOLE ☒ABANDONED ☒

DATE

8/17 1927 SCOUTMAP No. KANSAS SEC. 22 TWP. 15 R. 11WWELL No. 1 LilakSteele & Steele Company

CONTRACTOR

SECTION PLAT

		0	

660 Ft. from N. Line

_____ Ft. from S. Line

_____ Ft. from E. Line

660 Ft. from W. Line**ABANDONED**

Location _____

Rig up _____

Drilling and Remarks:

1" 3500' - 5"II & A

RECORD

Cased _____ in., _____ ft.

Sand _____

Gas _____

Oil _____

Total Depth _____

PRODUCTION

1st 24 hrs. Nat. _____

1st 24 hrs. after shot _____

Gas _____ Cu. Ft.

Dry Hole _____

Abandoned _____

Date

AUG 17 1927 192 S. J. LEWIS Scout


Russell
 Map No. Kans Sec. 22 Twp. 15 R. 11W
 Well No. 1 Farm
E. J. Thompson Company
Shuster & Starnes

660 Ft. from N. Line

Ft. from S. Line

Ft. from E. Line

660 Ft. from W. Line

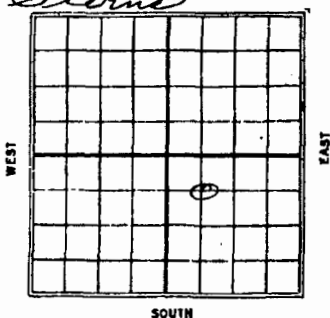

SOUTH

1926

Date	REPORT
10/50	location
10/27	same
11/5	—
11/10	same
11/17	same
11/24	same
12/1	rig
12/8	moving in tools
12/15	Spud
12/21	—
12/29	spud 260
1927	—
1/6	spud 300
1/12	Drly 575
1/19	" 580
1/26	" 805
2/2	" 1875
2/16	" 1925
2/23	" 2025
3/2	" 2100
3/9	" 2320

3/16 - T.D. 2320 - U.R. 10" @ 2247
 3/23 - Det 10" @ 2314 - Drly 2345
 3/30 - T.D. 2425 - U.R. 10" @ 2407
 4/6 - Drly 2470
 4/13 - " 2600
 4/20 - " 2875
 4/27 - Top Oswald sand 2992 -
 T.D. 2993 - U.R. 6"
 5/4 - T.D. 3091 - (S.L.M.) - Showail
 shut down for titles

5/11 —

5/18 —

5/25 —

6/1 —

6/8 —

6/15 - 3100-3104 - 2 bailers water
 Drly 3212 -

6/22 - T.D. 3310 - S.D. for 5" -

6/29 - Drly 3325 -

7/6 - T.D. 3325 - fishing shoe -

7/13 - Drly 3355 - Show bil 3343 -

7/20 - T.D. 3365 - U.R. 5" -

7/27 - T.D. 3365 - Shut down -

8/3 - T.D. 3365 - Starting up today -

8/10 - Drly 3460 -

8/12 - T.D. 3500 - (measured) -

8/17 - T.D. 3500' - 5" -

L. & A.

KANSAS

Section 22 Township 15 Range 11W

Well No. #1 Lilak

Company Streeter & Sterns

