

Kansas

Wildcat

Map No. _____ Sec. 26 Twp. 15 R. 11W

Well No. 1 Lillak

Prime Drlg. _____ Company _____

Contractor _____

NW NW NE

SECTION PLAT



330 Ft. from N. Line

Ft. from S. Line

Ft. from E. Line

330 Ft. from W. Line

Russell County

Phillips farmout

Texas DEW

Location X

Rig up

Drilling and Remarks:

Cased in, ft.

Sand

Gas

Oil

Total Depth

PRODUCTION

1st 24 hrs. Nat.

1st 24 hrs. after shot

Gas Cu. Ft.

Dry Hole

Abandoned

Date

MAR 1 1950 19

J. E. TYRA

Scout

Kansas

Wildcat

Map No. _____ Sec. 26 Twp. 15 R. 11W


Well No. 1 Lillak

Prime Drlg. _____ Company _____

Contractor _____

NW NW NE

SECTION PLAT

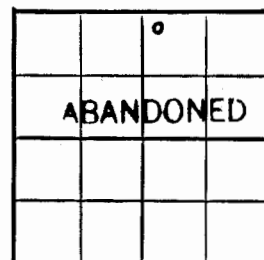

330 Ft. from N. Line

Ft. from S. Line

Ft. from E. Line

330 Ft. from W. Line

Russell County

Location

Rig up

Drilling and Remarks:

8" @ 303

Kub 2884

Br 2974

Lans 2994

ang 3326

and 3364

DVA

Date

MAR 1 5 1950

J. E. TYRA

19

Scout

Russell KANSAS

Sec. 26 Twp. 15 R. 11W

Well No. #1 Lillak Farm

Prime Drlg. Company

Contractor

Wildcat

330' Ft. from N. Line

Ft. from S. Line

Ft. from E. Line

330' Ft. from W. Line

NW NW NE

Phillips Farmout

Texas DHM

1950 Elev 1825' REPORT

3/1 Location

3/15 TD 3400'

8" @ 303'

Heeb 2884'

Br L 2974'

Lans 2994'


Cong 3326'

Arb 3364'

D&A

Aband.

ABANDONED

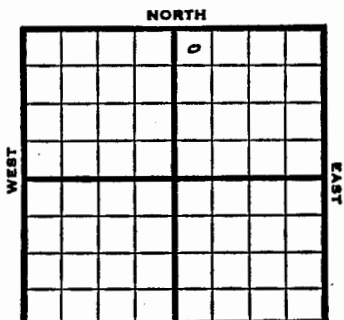

KANSAS

Russell

FORM 51 25M 3-49 PETROL

Section 26 Township 15 Range 11-W

Well No. #1 Lillak

Company Prime Drlg
Wildcat

