



Sec. 27 Twp. 15 R. 11W

Well No. #1 Heard Farm

B & R Drlg. Co. Company

B & R Contractor


330 Ft. from N. Line

Ft. from S. Line

Ft. from E. Line

330 Ft. from W. Line


NW NW SE

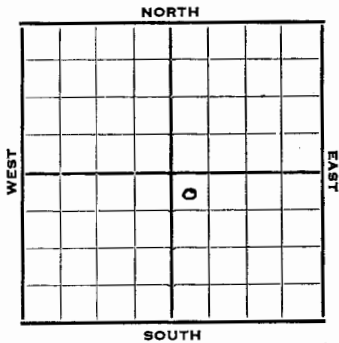

Section 27 Township 15 Range 11 W

Well No. # 1 Heard

Company B & R Drlg. Co.

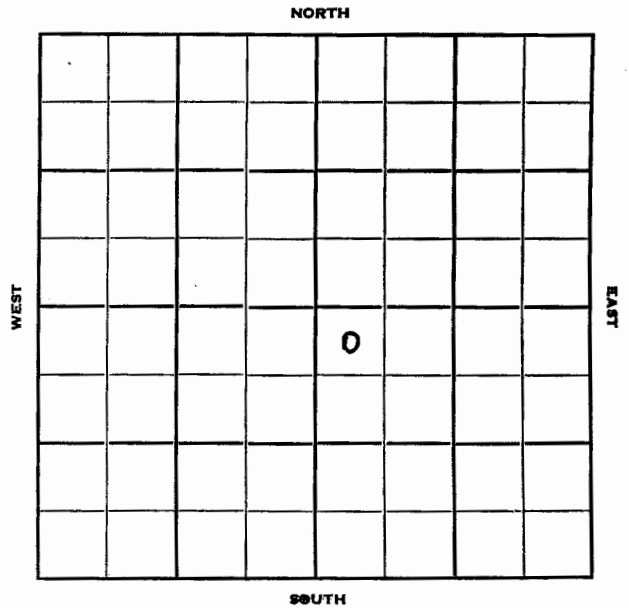

1952 Elev. 1853' REPORT

6/25 Spud 6-16-52  
8" @ 275'  
Anhy 715'  
Twist off 1850'

7/2 Tarkio 2403 Heeb. 2903  
Douglas 2930 Br Li 2996  
Lans. 3006 Drlg. 3170'

7/9 Arb. 3345-48 RTD 5" @ 3348

7/17 CO 3354 HFW

7/23 Spud 6-16-52  
D&A TD 3354 8" @ 275  
Anhy 715 Tarkio 2403  
Heeb. 2903 Doug 2930  
Br lime 2996 Lans. 3006  
BKC 3268 Arb. 3345  
5" @ 3348 TD 3354  
HFW PB 3343 17/3335-39 S/5 bwph  
PB 3331 31/3320-29 3 goph 500 A  
4 bw 1 1/2 bo 5 hr. 1000 A D&A