

Russell

KANSAS

Map No. 55 Sec. 28 Twp. 15 R. 11W

Well No. 1 Chegwiddden

Adair & Morton Company

FIRST REPORT Contractor

C NL SE SW


SECTION PLAT

Ft. from N. Line

990 Ft. from S. Line

660 Ft. from E. Line

Ft. from W. Line

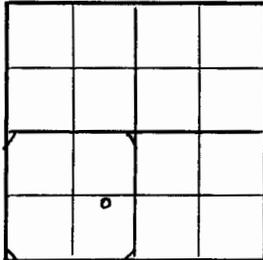

DAVIDSON POOL

Location XXX

Rig up \_\_\_\_\_

Drilling and Remarks:

Magnolia  
Farmout

RECORD

Cased \_\_\_\_\_ in. \_\_\_\_\_ ft.

Sand \_\_\_\_\_

Gas \_\_\_\_\_

Oil \_\_\_\_\_

Total Depth \_\_\_\_\_

PRODUCTION

1st 24 hrs. Nat. \_\_\_\_\_

1st 24 hrs. after shot \_\_\_\_\_

Gas \_\_\_\_\_ Cu. Ft.

Dry Hole \_\_\_\_\_

Abandoned \_\_\_\_\_

Date

DEC 9 1942 S. J. LEWIS Scout

Russell

Map No. 55 Sec. 28 Twp. 15 R. 11W

Well No. 1 Chegwiddden

Adair & Morton Company

ABANDONED Contractor

C NL SE SW


SECTION PLAT

Ft. from N. Line

990 Ft. from S. Line

660 Ft. from E. Line

Ft. from W. Line

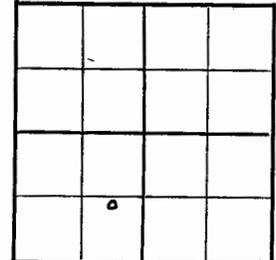

DAVIDSON POOL

Location \_\_\_\_\_

Rig up \_\_\_\_\_

Drilling and Remarks:

Core 3199  
5" C 3203  
2000 Acid  
Water

RECORD

Cased \_\_\_\_\_ in. \_\_\_\_\_ ft.

Sand \_\_\_\_\_

Gas \_\_\_\_\_

Oil \_\_\_\_\_

Total Depth 3219

PRODUCTION

1st 24 hrs. Nat. \_\_\_\_\_

1st 24 hrs. after shot \_\_\_\_\_

Gas \_\_\_\_\_ Cu. Ft.

Dry Hole \_\_\_\_\_

Abandoned \_\_\_\_\_

Date

FEB 10 1943 S. J. LEWIS Scout

**KANSAS**

Russell

Sec. 28 Twp. 15 R. 11-W

Well No. #1 Chegwidden Farm

Adair & Morton Company


Davidson pool

\_\_\_\_\_ Ft. from N. Line

990 Ft. from S. Line

660 Ft. from E. Line

\_\_\_\_\_ Ft. from W. Line

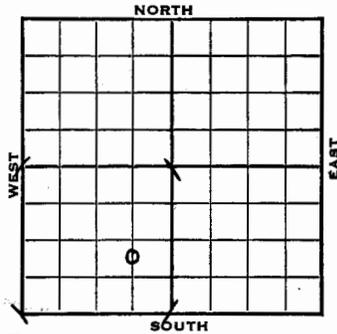

C NL SE SW Elev. 1733

1942 REPORT

- 12/9 Loc.  
Magnolia Farmout
- 12/16 "
- 12/22 "
- 12/29 **Derrick**
- 1943
- 1/6 8" Casing set at 325  
Drlg. 700'
- 1/13 Drlg. 2665'
- 1/20 Lams 2869  
BKC3171  
Congl 3193  
Arb 3204  
SO 3204-07  
TD 3207-09  
5" Casing set 3203 RUST.
- 1/27 " " "
- 2/3 T.D. 3219' SW  
P.B. 3211  
 $\frac{1}{2}$  bailer oil per hr. 2000 acid.
- 2/10 Arb. 3199  
5" @ 3203'  
T.D. 3219'  
2000 gal acid  
Water

**ABANDONED**

**KANSAS**

Russell

Section 28 Township 15 Range 11-W

Well No. #1 Chegwidden

Company Adair & Morton

Davidson Pool

NORTH

