

<u>County</u>						Russell	<u>State</u>								Kansas	
<u>Sec.</u>						29	(Blk. Twp.)				15				(Sur. Rge.)				11W	<u>Map No.</u>	
<u>Operator</u>																				Mid-Plains	
<u>Well No.</u>										3		<u>Farm</u>										Chegwidden "B"	
<u>Elev.</u>																				<u>Location</u>										C S L SE SW	
																				330										<u>Ft. From</u>										S	<u>Line</u>										SW																												
																				660										<u>Ft. From</u>										E	<u>Line</u>										<u>Quarter</u>																												
																				<u>1st. Report</u>																				OCT 18 1950																																							
<u>Completion</u>	
<u>Remarks</u>																																								I & E Drlg. - Contr.																																							
<u>Spudding Date</u>	

Drig. Data	Ghegwiddan Pool
Location	

J. E. TYRA

County Russell State Kansas

Sec. 29 (Blk. 15 (Sur. 11W (Twp. Map No.

Operator Mid-Plains

Well No. 3 Farm Chegwidden "B"

Elev. 1839 Location C S L SE SW

330 Ft. From S Line SW

660 Ft. From E Line Quarter

1st. Report

Completion DEC 6 1950

Remarks Chegwidden Pool

K & E Drlg. - Contr.

Spudding Date 10-20-50

Drig. Data	Oil well	TD 3315
8" @ 218	Anhy 650	Br. line 2910
Lans. 2991	SO 3016-24	DST 3163-74
open 45 min.	Rec. 35' ocm	Conn. 3284
Qts. 3312-15	TD 5" @ 3314	CO to 3211
5/ 3163-66	19/ 3168-74	3000 A
S/ 8 bfph	50% water	12/ 3020-24
500 A	S/ 2 1/2 boph	Comp. 60 bond

J. E. TYRA

Russell KANSAS

Sec. 29 Twp. 15 R. 11W

Well No. #3 Chegidden "B" Farm

Mid-Plains Company

K & E Drlg. - Contr. Contractor

Chegidden Pool


Ft. from N. Line

330' Ft. from S. Line

660' Ft. from E. Line

Ft. from W. Line

C S L SE SW

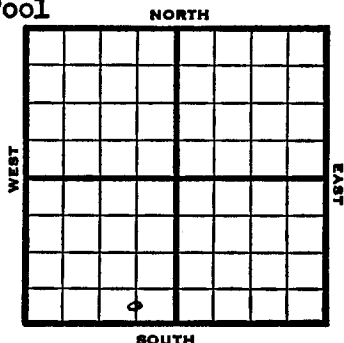

1950 Elev. 1839' REPORT

10/18 Location

12/6 Spud 10-20-50
Oil Well TD 3315
8" @ 218
Anhy .650 Br. Lime 2910
Lans. 2991 SO 3016-24
DST 3163-74 opn 45 min Rec. 35' ocm
Con. 3284 Qts. 3312-15 TD
5" @ 3314 CO to 3211
5/3163-66 19/3168-74 3000 A
S/8 bfph 50% wtr 12/3020-24
500 A S/2 1/2 boph Comp. 60 bopd

COMPLETED

Russell

Section 29 Township 15 Range 11W

Well No. #3 Chegidden "B"

Company Mid-Plains

