

County **Russell** State **Kansas**
 Sec. **29** (Blk. **15** (Sur. **11W** Map No.

Operator Mid-Plains Oil

Well No. **2** Farm **Cherwidden**

Elev.	Location	NW	SW	SE
-------	----------	----	----	----

FIRST REPORT

990 Ft. From S Line SE

380 Ft. From W Line Quarter

1st. Report **MAY 2 1951**

Completion _____

Remarks

K & E Drlg. - Contr.

Spudding Date **4-27-51**

Drig. Data Davidson Pool

8" @ 208 drlg. 300

J. E. TYRRELL

County Russell State Kansas
Sec. 29 (Bk. 15) (Sur. 11W) Map No. 11W

Operator Mid-Plains Oil

Well No. 2 Farm Chegwidde

Elev.	1775	Location	NW SW SE
-------	------	----------	----------

AMHIDEKNU

990 Ft. From S Line SE

330 Ft. From W Line Quarter

1st. Report

Completion JUN 6 1951

Remarks Davidson Pool

K & E Drlg. - Contr.

Spudding Date 4-27-51

Drig. Data D & A TD 3278

8" @ 208 KC 2924 SO 2946-61 Cong. 3218

Ch. Conf. 3237 TD 3278 5" @ 3277

5/ 3120-25 10/ 3111-17 PB 3000

20/ 2954-67 PB 2895 6/ 2864-69

4/ 2842-45 11/ 2765-75 6/ 2755-63

4/ 2749-52 D & A

J. E. TYRA

Russell

KANSAS

Sec. 29 Twp. 15 R. 11 W ✓

Well No. # 2 Chegidden Farm

Mid-Plains Oil Company

K & E Drlg. Contractor

Davidson Pool


Ft. from N. Line

990 Ft. from S. Line

Ft. from E. Line

330 Ft. from W. Line

NW SW SE

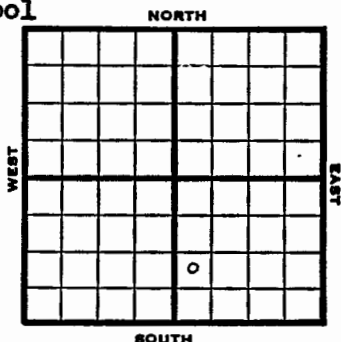

1951 Elev. 1775' REPORT

5/2 Spud 4-27-51
8" @ 208
Drlg. 300'

6/5 Spud 4-27-51
D&A TD 3278
8" @ 208
KC 2924 SO 2946-61
Cong. 3218 Ch Cong. 3237
TD 3278 5" @ 3277
5/3120-25 10/3111-17 PB 3000
20/2954-67 PB 2895
6/2864-69 4/2842-45
11/2765-75 6/2755-63
4/2749-52 D&A

ABANDONED

Russell KANSAS

Section 29 Township 15 Range 11 W

Well No. # 2 Chegidden

Company Mid-Plains Oil

