

County Russell Elev. _____
 Sec. 30 Twp. 15 Rgs. 11W
 Company Jerry Driscoll
 FarmName Fee No. 1

TOPS	DEPTH	LOG	DATUM	Loc. in Sec.
Anh.				NE SE SW
Tr.				
H.				
Tr.				
Dg.				Mast Drlg.
Bl.				
L.				
K.C.				
B.K.C.				
Ce.				
C.				
M.				
M.				
K.				
Mz.				
Me.				
V.				
S.				
S.				
A.				
R.				
Pe.				
G.				
T.D.				

Geol. _____
 Contr. _____
 Pool _____

0	14	53
---	----	----

FIRST REPORT
 DEC 14 53

Date Comm. drlg.

County Russell Elev. 1821
 Sec. 30 Twp. 15 Rgs. 11W
 Company Jerry Driscoll
 FarmName Fee No. 1

TOPS	DEPTH	LOG	DATUM	Loc. in Sec.
Anh.				NE SE SW
Tr.				
H.	<u>3889</u>		<u>1068</u>	
Tr.	<u>3907</u>		<u>1086</u>	
Dg.	<u>3921</u>		<u>1100</u>	Mast Drlg.
Bl.	<u>3982</u>		<u>1161</u>	
L.	<u>3994</u>		<u>1173</u>	
K.C.				
B.K.C.				
Ce.				
C.	<u>sd</u>	<u>3303</u>	<u>1482</u>	
M.				
M.				
K.				
Mz.				
Me.				
V.				
S.				
S.				
A.				
R.				
Pe.				
G.				
T.D.	<u>3315</u>			

Geol. _____
 Contr. _____
 Pool _____

0		
---	--	--

COMPLETE

Date Comm. 12-11-55 JAN 11 1956
8 5/8" @ 299/135 5 1/2" @ 3303/300
CO to 3305 S/4 boph 5% wtr/ 10 hr.
Comp. 25 bopd 5% wtr.

Russell KANSAS


SEC. 30 TWP. 15 R. 11W

WELL NO. #1 Fee FARM

COMPANY Jerry Driscoll

CONTRACTOR Mast Drlg

_____ Ft. from N. Line
 _____ Ft. from S. Line
 _____ Ft. from E. Line
 _____ Ft. from W. Line

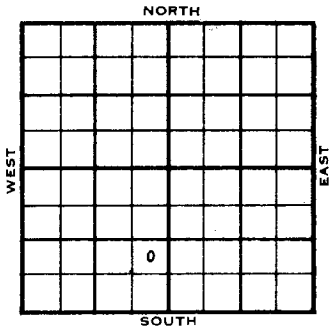

NE SE SW

1955 ELEVATION 1821' REPORT

12-14 Drlg.

1956

1-11 Comm. 12-11-55
 8 5/8" @ 299/135
 5 1/2" @ 3303/300
 CO to 3305
 S/ 4 boph, 5% wtr., 10 hrs.
 C mp. 25 bopd, 5% wtr.
 H: 2889'
 Tr. 2907
 Dodge 2921
 BL. 2982
 L. 2994
 Sd. 3303
 TD 3305'

COMPLETED

OX-78

Russell KANSAS

SECTION 30 TOWNSHIP 15 RANGE 11 W

WELL NO. #1 Fee

COMPANY Jerry Driscoll

