

KANSAS
Map No. 55 Sec. **31** Twp. **15** R. **11W**

Well No. **1 Driscoll**

Billings & Haynes Company

FIRST REPORT Contractor

C W L NE NW

SECTION PLAT

660 Ft. from N. Line

_____ Ft. from S. Line

990 Ft. from E. Line

_____ Ft. from W. Line

Driscoll Pool

	0		

Location _____

Rig up _____

Drilling and Remarks:

Cable

RECORD

Cased _____ in., _____ ft.

Sand _____

Gas _____

Oil _____

Total Depth _____

PRODUCTION

1st 24 hrs. Nat. _____

1st 24 hrs. after shot _____

Gas _____ Cu. Ft.

Dry Hole _____

Abandoned _____

Date

SEP 8 1943 19 **S. J. LEWIS** Scout

KANSAS
Map No. 55 Sec. **31** Twp. **15** R. **11W**

Well No. **1 Driscoll**

Billings & Haynes Company

COMPLETED Contractor

C W L NE NW

SECTION PLAT

660 Ft. from N. Line

_____ Ft. from S. Line

990 Ft. from E. Line

_____ Ft. from W. Line

	0		

Driscoll Pool

Location _____

Rig up _____

Drilling and Remarks:

Cu 48223

5' @ 3287

500 acid

Pump 400 P.D.

37 1/2

RECORD

Cased _____ in., _____ ft.

Sand _____

Gas _____

Oil _____

Total Depth 3298

PRODUCTION

1st 24 hrs. Nat. _____

1st 24 hrs. after shot _____

Gas _____ Cu. Ft.

Dry Hole _____

Abandoned _____

Date

DEC 15 1943 19 **S. J. LEWIS** Scout

KANSAS

Russell

Sec. 31 Twp. 15 R. 11-W

Well No. #1 Driscoll Farm


Billings & Haynes Company

660 Ft. from N. Line

 Ft. from S. Line

990 Ft. from E. Line

 Ft. from W. Line

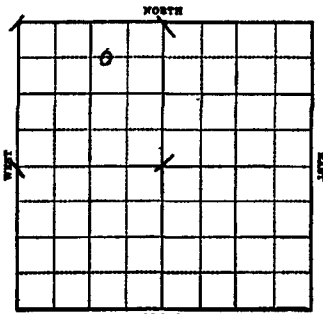

Elev. 1808 1818

1943
12/15

5" @ 3281
ARB 3273
500 acid
Pump 400 Pot.
TD 3290
Gravity 37.2

COMPLETED

1943	REPORT
9/8	Cable
9/15	"
9/22	325 fsg.
9/29	12" @ 360' Drlg. 475'
10/6	10" @ 677' Drlg. 1505'
10/13	8" @ 2007 Drlg. 2180
10/20	8" @ 2309 Drlg. 2310'
10/27	8" @ 2313 Topeka 2632 Drlg. 2905'
11/3	Lens 2985 6" @ 3000' T.D. 3160
11/10	UR 6" 6" @ 3087 3167-1000 acid No help
11/17	3000 Acid No Help
12/ 1	Arb 3273 SO TD 3289
12/8	5" @ 3281- 1200' oil 12 hrs. 500 acid

OVER

KANSAS

Russell

FORM 51 5M PETROL

Section 31 Township 15 Range 11-W

Well No. #1 Driscoll

Company Billings & Haynes

