

Russell

Map No. 55 Sec. 33 Twp. 15 R. 11WWell No. 1 BorrellStanolind

Company

ABANDONED

Contractor

C NL NE NE


330 Ft. from N. Line

Ft. from S. Line

660 Ft. from E. Line

Ft. from W. Line

SECTION PLAT

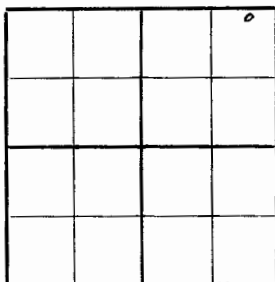

GREENVALE POOL

Location

Rig up

Drilling and Remarks:

Cur 3240
Water.

RECORD

Cased in, ft.

Sand

Gas

Oil

Total Depth 3245

PRODUCTION

1st 24 hrs. Nat.

1st 24 hrs. after shot

Gas Cu. Ft.

Dry Hole

Abandoned

Date

JUN 3 1942 19S. J. LEWIS

Scout

Map No. 55 Sec. 33 Twp. 15 R. 11WWell No. 1 BorrellStanolind

Company

FIRST REPORT

Contractor

C NL NE NE


330 Ft. from N. Line

Ft. from S. Line

660 Ft. from E. Line

Ft. from W. Line

SECTION PLAT

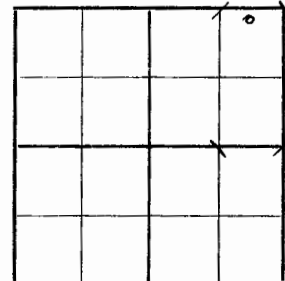

GREENVALE POOL

Location XX

Rig up

Drilling and Remarks:

RECORD

Cased in, ft.

Sand

Gas

Oil

Total Depth

PRODUCTION

1st 24 hrs. Nat.

1st 24 hrs. after shot

Gas Cu. Ft.

Dry Hole

Abandoned

Date

APR 15 1942

19

S. J. LEWIS

Scout

KANSAS

Russell

Sec. 33 Twp. 15 R. 11-W

Well No. #1 Borrell Farm

Stanolind Company

(Greenvale)


330 Ft. from N. Line

 Ft. from S. Line

660 Ft. from E. Line

 Ft. from W. Line

Elev. 1754

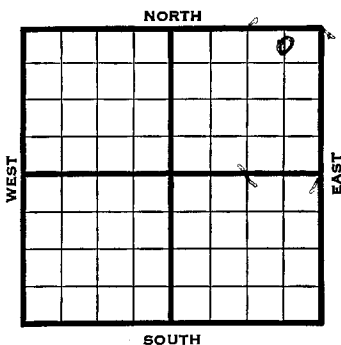

1942

REPORT

4/15

Location

4/29

13" - 442' Drlg. 1740'

5/6

Lans. 2867' Cong. 3193'

Drlg. 3198'

5/13

Arb. 3240-45' T.D. 4" - 3073'

P.B. to 3093' RUST.

5/20

P.B. to 3089' 51 shots 3075-82'

3000 acid.

5/27

Shut down.

6/3

Arb. 3240'

T.D. 3245'

Water.

ABANDONED

KANSAS

Russell

Section 33 Township 15 Range 11-W

Well No. #1 Borrell

Company Stanolind

