

Drig. Data

Davidson Pool

Location

J. E. TYRA

[illegible]

O.W.P.B.

County	Russell	State	Kansas
Sec.	33	(Bk. Twp.) 15	(Sur. Rge.) 11W Map No.
Operator	Salina Drlg.		
Well No.	1	Farm	Borrell
Elev.	1736	Location	SW NW NE
		990 Ft. From N Line NE	
		330 Ft. From W Line Quarter	
		1st. Report APR 14 1954	
		Completion	
		Remarks OWPB	
		O.W.P.B.	
		Spudding Date	

Drlg. Data

Lens. 2865 Cong. 3185 Arb. 3192
 5" @ 3193 OTD 3200 PB 2940 18/ 2872-
 78 SP 2906 1500 A 60/ 2914-21
 1500 A

J. G. McGEHEE

County	Russell	State	Kansas
Sec.	33	(Bk. Twp.) 15	(Sur. Rge.) 11W Map No.
Operator	Salina Drlg.		
Well No.	1	Farm	Borrell
Elev.	1736	Location	SW NW NE
		990 Ft. From N Line NE	
		330 Ft. From W Line Quarter	
		1st. Report	
		Completion JUN 15 1954	
		Remarks OWPB	
		Spudding Date	

Drlg. Data D & A TD 3240

Lens. 2865 Cong. 3185 Arb. 3192
 5" @ 3194 OTD 3200 DD 3240 HFW
 PB 2940 18/ 2872-78 SP 2906 1500 A
 60/ 2914-21 1500 A wtr.

D & A

J. G. McGEHEE

Russell

KANSAS

Sec. 33 Twp. 15 W. P. B. Range 11 W

Well No. # 1 Barrell Farm

SALINA
Sterling Drlg. Company

Contractor


990 Davidson Pool
Ft. from N. Line

Ft. from S. Line

Ft. from E. Line

330 Ft. from W. Line


SW NW NE

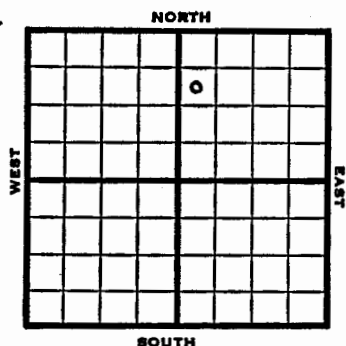

Section 33 Township 15 Range 11 W

Well No. # 1 Barrell

SALINA
Sterling Drlg. Company

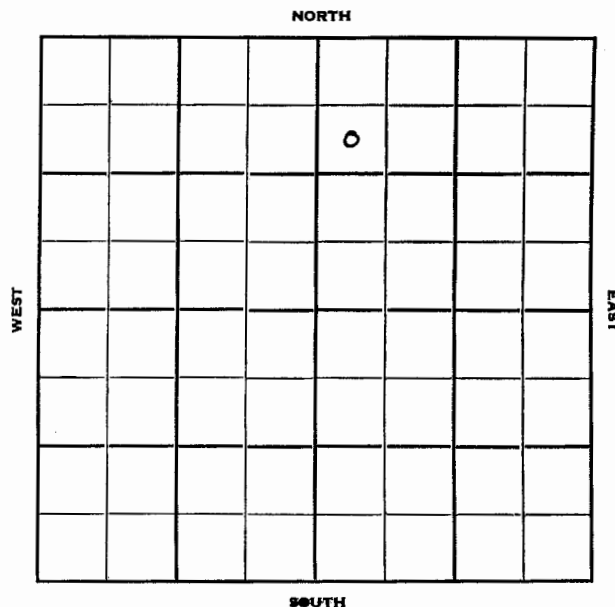

1951 Elv. 1736' REPORT

2/14 Location

3/7 Spud 2-8-51
Oil Well TD 3200
8" @ 269
Anhy 600' Heeb. 2774
Toronto 2790 Douglas 2806
Lans. 2865 Cong. 3185
Arb. 3192-94
5" @ 3193
TD 3200 S/15 boph Comp. 50 boph

COMPLETED

O. W. P. B.

1954 4/14 Lans 2865 Cong 3185' Arb 3192'

5" @ 3193'
OTD 3200'
PB 2940'
18/ 2872'-78
SP2906
1500 A 60/ 2914-21
1500 A

6/15 D&A - TD 3240'
Lans 2865', Cong 3185', Arb. 3192'
5" @ 3194
OTD 3200, DD 3240, HEW
PB 2940, 18/2872-78, SP 2906, 1500A
60/2914-21, 1500A wtr.
D&A

ABANDONED