



Russell KANSAS  
15 11W

Sec. 33 Twp. 15 R. 11W

Well No. #1 Chitwidden Chegwidden Farm

Seegar Oil Company

Sterling - Contr. Contractor

Davidson Pool


990' Ft. from N. Line

Ft. from S. Line

330' Ft. from E. Line

Ft. from W. Line


SE NE NW

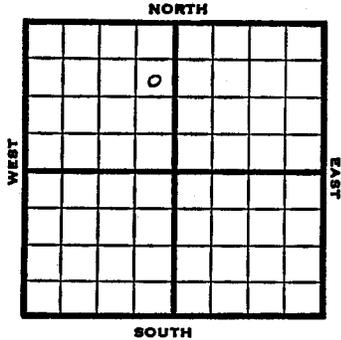

Section 33 Township 15 Range 11 W

Well No. #1 Chitwidden Chegwidden

Company Seegar Oil

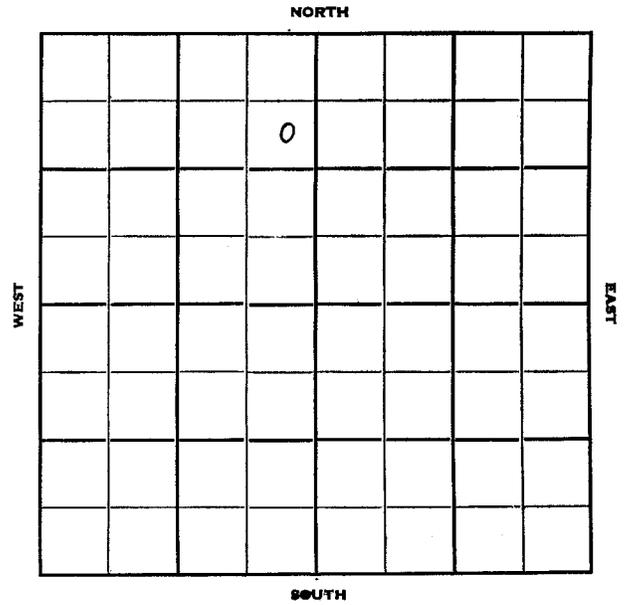

|      |                                 |        |
|------|---------------------------------|--------|
| 1951 | Elev. 1763'                     | REPORT |
| 6/29 | Spud 6-19-51                    |        |
|      | 8" @ 290                        |        |
|      | Drlg. 2690'                     |        |
| 7/25 | Spud 6-19-51                    |        |
|      | D & A TD 3245'                  |        |
|      | 8" @ 290' KC 2898' Arb. 3226'   |        |
|      | TD 3228' 5" @ 3227' DD 3245'    |        |
|      | FU 125' oil 12 hr. 1000 A       |        |
|      | S/ water & SSO 12/2920-24       |        |
|      | 500 A S/water PB 2890'          |        |
|      | 33/2824-36 1000 A S/water & tar |        |
|      | 4000 A no inc.                  |        |
|      | D & A                           |        |
|      | <b>ABANDONED</b>                |        |