

Map No. _____ Sec. 33 Twp. 15 R. 11WWell No. 1 Chegwidden

E. L. Wirth et al.

Company

FIRST REPORT

Contractor

C N L NW

SECTION PLAT


330 Ft. from N. Line

_____ Ft. from S. Line

_____ Ft. from E. Line

1320

_____ Ft. from W. Line

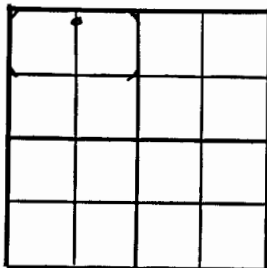

Russell County

Location _____

Rig up _____

Drilling and Remarks:

8" @ 210

drlg. 1900

RECORD

Cased _____ in., _____ ft.

Sand _____

Gas _____

Oil _____

Total Depth _____

PRODUCTION

1st 24 hrs. Nat. _____

1st 24 hrs. after shot _____

Gas _____ Cu. Ft.

Dry Hole _____

Abandoned _____

Date

MAR 23 1949 19

S. J. LEWIS

Scout

Map No. 55 Sec. 33 Twp. 15 R. 11WWell No. 1 Chegwidden

E. L. Werth et al.

Company

CORRECTION

Contractor

NW/C

SECTION PLAT


330 Ft. from N. Line

_____ Ft. from S. Line

_____ Ft. from E. Line

330

_____ Ft. from W. Line

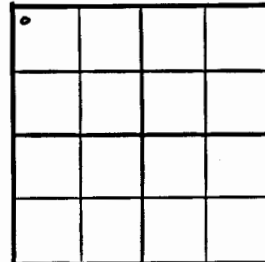

Russell County

Location _____

Rig up _____

Drilling and Remarks:

Reported

C N L NW

RECORD

Cased _____ in., _____ ft.

Sand _____

Gas _____

Oil _____

Total Depth _____

PRODUCTION

1st 24 hrs. Nat. _____

1st 24 hrs. after shot _____

Gas _____ Cu. Ft.

Dry Hole _____

Abandoned _____

Date

APR 13 1949 19

S. J. LEWIS

Scout

Kansas

Map No. 55 Sec. 33 Twp. 15 R. 11WWell No. 1 Chegwidden

E. L. Wirth et al.

Company

ABANDONED


Contractor

NW/4

E. 1/4
SECTION PLAT330 Ft. from N. Line

Ft. from S. Line

Ft. from E. Line

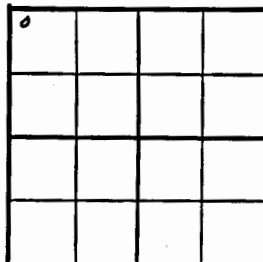330 Ft. from W. Line

Russell County

Location

Rig up

Drilling and Remarks:

Per 3307

RECORD

Cased _____ in., _____ ft.

Sand _____

Gas _____

Oil _____

Total Depth 3314

PRODUCTION

1st 24 hrs. Nat. _____

1st 24 hrs. after shot _____

Gas _____ Cu. Ft.

Dry Hole _____

Abandoned _____

Date

APR 13 1949 19S. J. LEWIS

Scout

KANSAS

Russell

11W

Sec. 33 Twp. 15 R. 11W

Well No. #1 Chegwidden Farm

E. L. Wirth et al

Company


Chegwidden Pool

330' Ft. from N. Line

Ft. from S. Line

Ft. from E. Line

330
1320' Ft. from W. Line

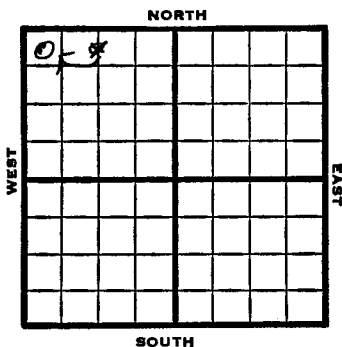

6-N-1-W S.W./C.

1949 Elev 1836' REPORT

3/23 8" @ 210'
Drlg. 1900'
3/30 Drlg 3188'
4/6 "
4/13 TD 3314'
Arb. 3307'
Aband.
ABANDONED

Russell

KANSAS

Section 33 Township 15 Range 11W

Well No. 1 Chegwidden

Company E.L. Wirth et al

Chegwidden

