

Russell

KANSAS
Map No. 33 Sec. 33 Twp. 15 R. 11W


Well No. 2 C. Borell

Texas Company

FIRST REPORT Contractor

C SE NW

SECTION PLAT

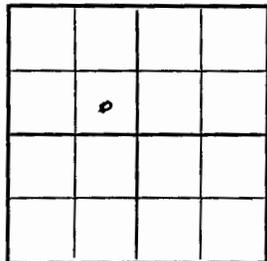

Ft. from N. Line

660 Ft. from S. Line

660 Ft. from E. Line

Ft. from W. Line

DRESCOLL POOL

Location XXX

Rig up

Drilling and Remarks:

RECORD

Cased in, ft.

Sand

Gas

Oil

Total Depth

PRODUCTION

1st 24 hrs. Nat.

1st 24 hrs. after shot

Gas Cu. Ft.

Dry Hole

Abandoned

Date

MAY 26 1943 19

S. J. LEWIS Scout

KANSAS

Russell

Map No. 33 Sec. 33 Twp. 15 R. 11W


Well No. 2 C. Borell

Texas Company

COMPLETED Contractor

C SE NW

SECTION PLAT

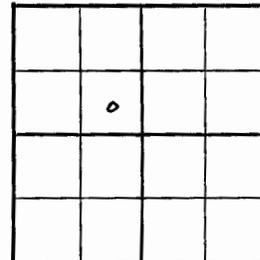

Ft. from N. Line

660 Ft. from S. Line

660 Ft. from E. Line

Ft. from W. Line

DRESCOLL POOL

Location

Rig up

Drilling and Remarks:

*Co 83274
5" @ 3275'
500 cu. ft.
Pump 142 P.T.*

RECORD

Cased in, ft.

Sand

Gas

Oil

Total Depth 3270 1/2

PRODUCTION

1st 24 hrs. Nat.

1st 24 hrs. after shot

Gas Cu. Ft.

Dry Hole

Abandoned

Date

JUN 30 1943 19

S. J. LEWIS Scout

KANSAS

Russell

Sec. 33 Twp. 15 R. 11-W

Well No. #2 C, Borell Farm

Texas Company

Drescoll


_____ Ft. from N. Line

660 Ft. from S. Line

660 Ft. from E. Line

_____ Ft. from W. Line

Elev. 1797

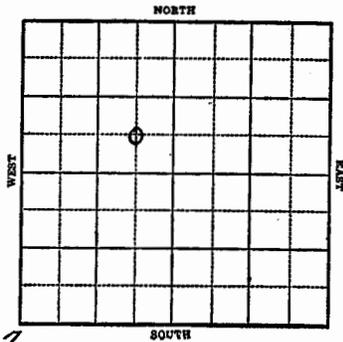

1943

R E P O R T

5/26

Location

6/2

10" @ 387
T.D. 394 WOC.

6/9

Drlg. 1745'

6/16

Lans 2940'
Drlg. 3175'

6/23

Arb 3274
T.D. 3280½'
5" @ 3275'
Pump 120 oil in 13 hrs.

6/30

Arb. 3274
5" @ 3275'
T.D. 3280½'
500 gal acid
Pump 142 Pot.
Gravity 37.2

COMPLETED

KANSAS

Russell

Section 33 Township 15 Range 11-W

Well No. #2 C. Borell

Company Texas

