


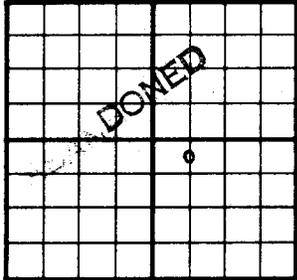

County Russell State Kansas  
 Sec. 33 (Blk. 15 (Sur. 11W (Twp.) (Rge.) Map No.  
 Operator H. H. Blair  
 Well No. 4 Farm Foster  
 Elev. 1758 Location C N $\frac{1}{2}$  NW SE



330 Ft. From N Line SE  
660 Ft. From W Line Quarter  
 Ist. Report \_\_\_\_\_  
 Completion DEC 1 1954  
 Remarks Davidson Pool  
Mast Drlg. - Contr.  
 Spudding Date 9-24-54

Drlg. Data  
8" @ 330 Arb. 3350 TD 3363

D & A

ELSEN OLSTRAP

KANSAS

SEC. 33 TWP. Russell 15 R. 11W


WELL NO. #4 Foster FARM

COMPANY H.H. Blair

CONTRACTOR Mast Tools

330 Ft. from N. Line  
Ft. from S. Line  
Ft. from E. Line  
660 Ft. from W. Line  
C N/2 NW SE

Davidson Pool

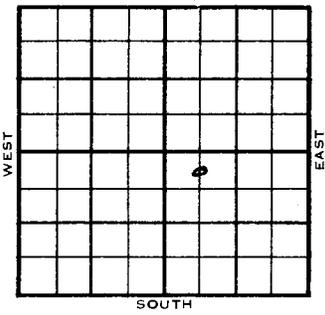

1954 ELEVATION 1758' REPORT

9/29 Spud 9-24-54  
8" @ 330'  
Drlg. 2600'  
12/1 Spud 9-24-54  
8" @ 330'  
Arb. 3350'  
TD 3363'  
D&A

ABANDONED

DX 78-1

Russell KANSAS

Section 33 Township 15 Range 11W

Well No. Foster

Company H. H. Blair

