


Map No. 55 Sec. 33 Twp. 15 R. 11W

Well No. 3 Foster

H. H. Blair Company

FIRST REPORT Contractor

SECTION PLAT

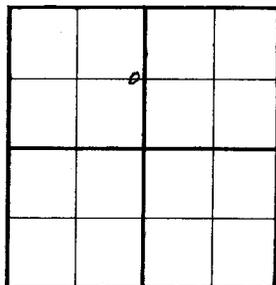

C E L NW

1320 Ft. from N. Line

_____ Ft. from S. Line

330 Ft. from E. Line

_____ Ft. from W. Line

DAVIDSON POOL

Location X

RECORD

Cased _____ in., _____ ft.

Sand _____

Gas _____

Oil _____

Total Depth _____

PRODUCTION

1st 24 hrs. Nat. _____

1st 24 hrs. after shot _____

Gas _____ Cu. Ft.

Dry Hole _____

Abandoned _____

Date

AUG 20 1941

19

S. J. LEWIS Scout


Map No. _____ Sec. 33 Twp. 15 R. 11W

Well No. 1 Foster "B"

H. H. Blair Company

CORRECTION Contractor

SECTION PLAT

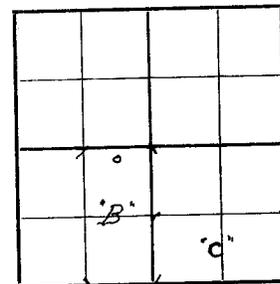

C N L NE SW

330 Ft. from N. Line

_____ Ft. from S. Line

660 Ft. from E. Line

_____ Ft. from W. Line

DAVIDSON POOL

Location _____

RECORD

Cased _____ in., _____ ft.

Sand _____

Gas _____

Oil _____

Total Depth _____

PRODUCTION

1st 24 hrs. Nat. _____

1st 24 hrs. after shot _____

Gas _____ Cu. Ft.

Dry Hole _____

Abandoned _____

Date

AUG 27 1941

19

S. J. LEWIS Scout

Sec. 33 Twp. 15 R. 11-W

Well No. ~~#1~~ Foster "B" Farm

H. H. Blair Company

(Davidson)


1320 ³³⁰ Ft. from N. Line

Ft. from S. Line

660
380 Ft. from E. Line

Ft. from W. Line

Elev. 1788

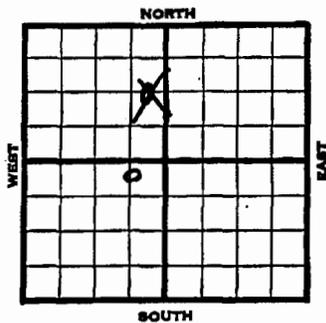

1941	REPORT
8/20	Location
8/28	Cellar.
9/4	"
9/11	"
9/18	"
9/25	"
10/2	"
10/9	"
10/16	"
10/23	Rigging up.
10/30	" "
11/6	" "
11/13	12" - 381' Anhy 639'
	10" - 645' Drlg. 1865'
11/20	8" - 1943' Drlg. 2320'
11/26	2377' U.R. 8"
12/4	Topexa 2578' Lans. 2945'
	T.D. 3023' Run 7".
12/11	Art. 3264-69
	TD 7" @ 3264-2500' oil.
	OVER

1941
12/18 Arb. 3264-69 TD
7" @ 3264-2500' oil
12/24 " " " "
12/31 " " " "
1942
1/8 " " " "
1/14 Arb. 3264'
7" - 3020'
5" - 3264'
T.D. 3269'
Potential 233 bbls., pump.
40. Gravity

COMPLETED

KANSAS

Russell

Map No. 55 Sec. 33 Twp. 15 R. 11W

Well No. 1 Foster "B"

H. H. Blair Company

COMPLETED Contractor

C N L N E S W


330 Ft. from N. Line

_____ Ft. from S. Line

660 Ft. from E. Line

_____ Ft. from W. Line

SECTION PLAT

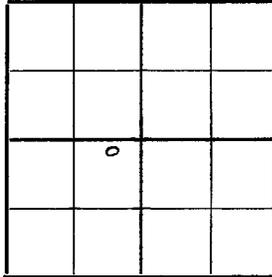

DAVIDSON POOL

Location _____

Rig up _____

Drilling and Remarks:

Ce 8264

7" C 3020

5" C 3264

Pump 233 P.Y.

400 Gr

RECORD

Cased _____ in., _____ ft.

Sand _____

Gas _____

Oil _____

Total Depth 3269

PRODUCTION

1st 24 hrs. Nat. _____

1st 24 hrs. after shot _____

Gas _____ Cu. Ft.

Dry Hole _____

Abandoned _____

Date

JAN 14 1942 19

S. J. LEWIS Scout

KANSAS

FORM 51 5M 4-41 PETROL


Russell

Section 33 Township 15 Range 11-W

Well No. #18 Foster "B"

Company H. H. Blair

NORTH Davidson pool

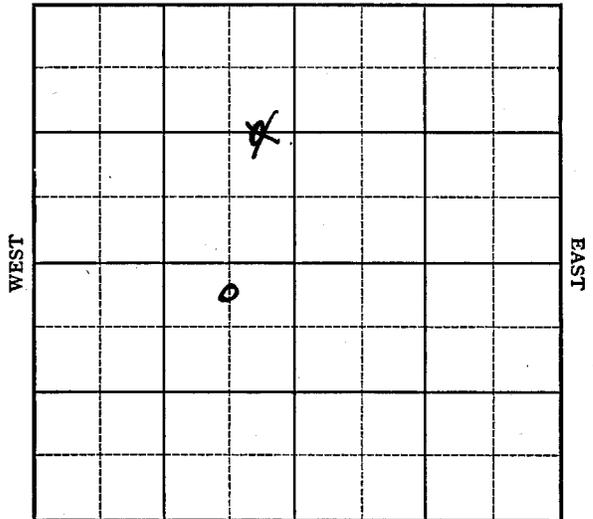

SOUTH