

Russell KANSAS

Sec. 33 Twp. 15 R. 11 W

Well No. ~~#1~~ Foster Farm

H. H. Blair & Hill & Hill Company

Contractor

Davison


Ft. from N. Line

330 Ft. from S. Line

Ft. from E. Line

330 Ft. from W. Line

SW SW SE

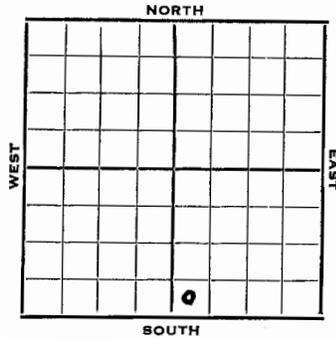

1952 Elev. 1783' REPORT

9/10 Location

9/17 10" @ 281 Anhy 635'
Drlg. 1955'

9/24 Heeb 2814' Br li 2906' Lans 2927'
DST 2942-54, 1 hr, 50' M 410#
Cong 3224'
Drlg. 3364'

10/1 Spud 9-9-52
D & A TD 3280' 10" @ 281
Anhy 635' Heeb 2814' Br. lime 2906'
Lans. 2927'
DST 2942-54 open 1 hr. rec 50' mud
410# Cong. 3224' Arb. 3271'
DST 3273-80 open 1 hr. rec 70' SWCM
1100#
D & A

ABANDONED

Russell

KANSAS

Section 33 Township 15 Range 11W

Well No. ~~#1~~ Foster

Company H. H. Blair & Hill & Hill

