

Sec. **33** Twp. **15** R. **11-W**

Well No. **#1 Foster** Farm

H. H. Blair Company


(Driscoll)

_____ Ft. from N. Line

320 Ft. from S. Line

660 Ft. from E. Line

_____ Ft. from W. Line

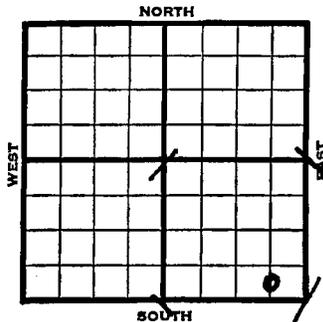

Elev. 1785

1941

8/6

Lansing 2913'
 7" @ 2995'
 TD 3008'
 5000 acid
 Pump 200 potential
 Gravity 38

COMPLETED

1941		REPORT
4/30	Cable rig. Rigging up. Spud.	
5/8	Drlg. 465'	
5/15	Anhy 625' 10" - 642'	
	Drlg. 1810'	
5/22	8" - 1938' T.D. 2295' U.R. 8".	
5/28	8" - 2346' Drlg. 2445'	
6/5	Drlg. 2850'	
6/12	Lans. 2913' ^{2913'} Drlg. 2930'	
6/19	Lans. 2913' (Corrected)	
	7" - 2928' Gas 2950-51'	
	S.S.O. 2973-77 & 3000-05'	
	Drlg. 3005'	
6/26	Inc. oil 3005-08' T.D.	
	Drill cement. 7" cement. 2995'	
7/3	5000 acid.	
7/10	Pump 113 oil 13 hours.	
7/17	" " " "	
7/24	" " " "	
7/31	" " " "	
		OVER

KANSAS

FORM 51 5M 4-41 PETROL


Russell

Section 33 Township 15 Range 11-W

Well No. #1 Foster

Company H. H. Blair

NORTH **Criscoll Pool**

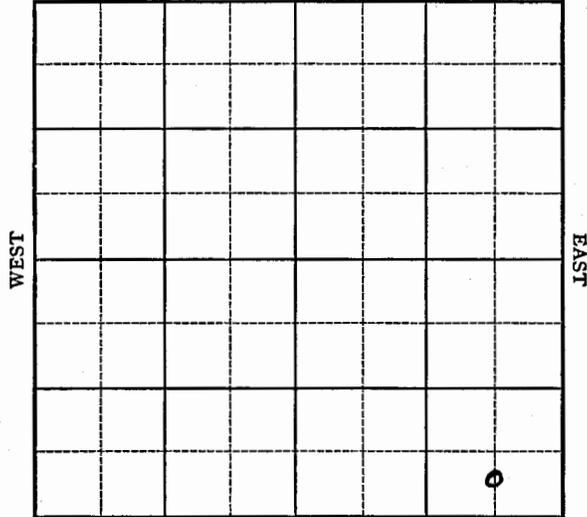

SOUTH