

Map No. 55 Sec. 34 Twp. 15 R. 11WWell No. 2 Sidey

Phillips

Company

FIRST REPORT

Contractor

SECTION PLAT

C S L SE SW

Ft. from N. Line

330 Ft. from S. Line660 Ft. from E. Line

Ft. from W. Line

DRISCOLL POOL

Location X

RECORD

Cased _____ in., _____ ft.

Sand _____

Gas _____

Oil _____

Total Depth _____

PRODUCTION

1st 24 hrs. Nat. _____

1st 24 hrs. after shot _____

Gas _____ Cu. Ft.

Dry Hole _____

Abandoned _____

Date

MAY 27 1941

19

S. J. LEWIS Scout

Map No. _____ Sec. 34 Twp. 15 R. 11WWell No. 2 Sidey

Phillips Petroleum

Company

COMPLETED

Contractor

SECTION PLAT

C S L SE SW

Ft. from N. Line

330 Ft. from S. Line660 Ft. from E. Line

Ft. from W. Line

DAVIDSON POOL

Location _____

RECORD

Cased _____ in., _____ ft.

Sand _____

Gas _____

Oil _____

Total Depth 330 1/2

PRODUCTION

1st 24 hrs. Nat. _____

1st 24 hrs. after shot _____

Gas _____ Cu. Ft.

Dry Hole _____

Abandoned _____

Ar Y 3293
5" @ 3294
1000 acio l
Pump 90 Pst

38° 42'

Date

JUL 23 1941

19

S. J. LEWIS Scout

Sec. 34 Twp. 15 R. 11-W

Well No. #2 Sidey Farm

Phillips Company

(Driscoll)


_____ Ft. from N. Line

330 Ft. from S. Line

660 Ft. from E. Line

_____ Ft. from W. Line

Elev. 1851

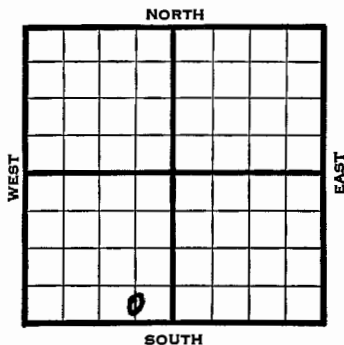

1941	REPORT
5/27	Location
6/5	8" - 496' WOC.
6/12	anhv. 691' Drlg. 2760'
6/19	Lens. 2977' Arb. 3293-96' T.D.
	5" - 3294' RUST.
6/26	" " "
7/3	T.D. 3301½' Swab 41 oil in 12 hours.
7/10	2600' oil.
7/17	" "
7/23	Arb. 3293'
	5" - 3294'
	T.D. 3301½'
	1000 acid.
	Potential 90 bbls., pump.
	38. Gravity
	COMPLETED

KANSAS

FORM 51 5M 4-41 PETROL

Russell

Section 34 Township 15 Range 11-W

Well No. #2 Sidey

Company Phillips

Driscoll pool

