

Map No. 55 Sec. 34 Twp. 15 R. 11WWell No. 1 Sidey

Phillips Company

FIRST REPORT Contractor

SECTION PLAT

C N L NE SW


330 Ft. from N. Line

Ft. from S. Line

660 Ft. from E. Line

Ft. from W. Line

DRISCOLL POOL

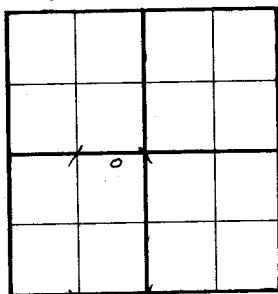

Location _____

RECORD

Cased _____ in., _____ ft.

Sand _____

Gas _____

Oil _____

Total Depth _____

PRODUCTION

1st 24 hrs. Nat. _____

1st 24 hrs. after shot _____

Gas _____ Cu. Ft.

Dry Hole _____

Abandoned _____

Date

JUL 1 1941

19

S. J. LEWIS

Scout

KANSAS

Map No. _____ Sec. 34 Twp. 15 R. 11WWell No. 1 Sidey

Phillips Petroleum Company

ABANDONED Contractor

SECTION PLAT

C N L NE SW


330 Ft. from N. Line

Ft. from S. Line

660 Ft. from E. Line

Ft. from W. Line

DRISCOLL POOL

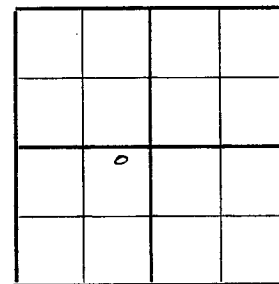

Location _____

RECORD

Cased _____ in., _____ ft.

Sand _____

Gas _____

Oil _____

Total Depth 3304

PRODUCTION

1st 24 hrs. Nat. _____

1st 24 hrs. after shot _____

Gas _____ Cu. Ft.

Dry Hole _____

Abandoned _____

Date

JUL 1 1941

19

S. J. LEWIS

Scout

KANSAS


Russell

Sec. 34 Twp. 15 R. 11-WWell No. #1 Sidney FarmPhillips Company

(Dr 150011)

330 Ft. from N. Line Ft. from S. Line660 Ft. from E. Line Ft. from W. Line

Elev. 1834

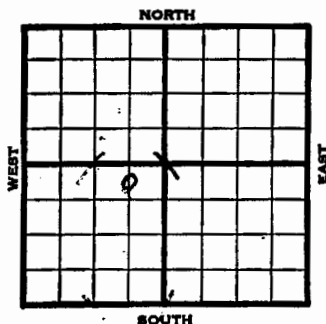1941
7/1

Arb. 3288'

5" - 3288'

T.D. 3304'

1000 acid.

Water.

ABANDONED

1941	REPORT			
2/12	8" - 496'	WOC.		
2/20	Drlg. 2770'			
2/27	Lans. 2963'	Arb. 3288-93'	TD	
	5" - 3288'	RUST.		
3/13	Bail 16 bbls.	oil & 6 water.		
3/20	"	"	"	"
3/27	"	"	"	"
4/2	"	"	"	"
4/10	"	"	"	"
4/18	"	"	"	"
4/24	"	"	"	"
5/1	"	"	"	"
5/8	"	"	"	"
5/15	"	"	"	"
5/22	"	"	"	"
5/28	"	"	"	"
6/5	"	"	"	"
6/12	"	"	"	"
6/19	"	"	"	"
6/26	"	"	"	"
	OVER			

KANSAS

Russell

Form 51-5M-7-40-Palace

Section 34 Township 15 Range 11-W

Well No. #1 Sider

Company Phillips

