

KANSAS


Map No. 55 Sec. 34 Twp. 15 R. 11WWell No. 1 Phillips

Herndon Drlg. Company

FIRST REPORT Contractor

SW SE

SECTION PLAT

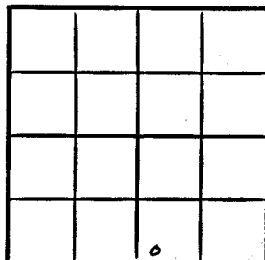

Ft. from N. Line

330 Ft. from S. Line

Ft. from E. Line

330 Ft. from W. Line

Russell County

Location

Rig up

Drilling and Remarks:

8" @ 465 WOC

RECORD

Cased in, ft.

Sand

Gas

Oil

Total Depth

PRODUCTION

1st 24 hrs. Nat.

1st 24 hrs. after shot

Gas Cu. Ft.

Dry Hole

Abandoned

Date

APR 30 1947 19 S. J. LEWIS Scout

KANSAS


Map No. 55 Sec. 34 Twp. 15 R. 11WWell No. 1 Phillips

Herndon Drlg. Company

ABANDONED Contractor

SW SE

SECTION PLAT

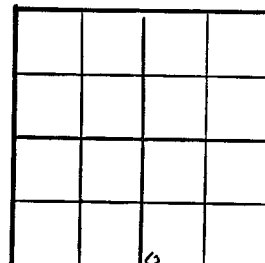

Ft. from N. Line

330 Ft. from S. Line

Ft. from E. Line

330 Ft. from W. Line

Russell County

Location

Rig up

Drilling and Remarks:

Quartzite 82 ft

RECORD

Cased in, ft.

Sand

Gas

Oil

Total Depth 330

PRODUCTION

1st 24 hrs. Nat.

1st 24 hrs. after shot

Gas Cu. Ft.

Dry Hole

Abandoned

Date

MAY 14 1947 19 S. J. LEWIS Scout

KANSAS

Russell

Sec. 34 Twp. 15 R. 11-W

Well No. #1 Phillips Farm

Herndon Drlg Company
Davidson Pool


Ft. from N. Line

330 Ft. from S. Line

Ft. from E. Line

330 Ft. from W. Line

SW SE

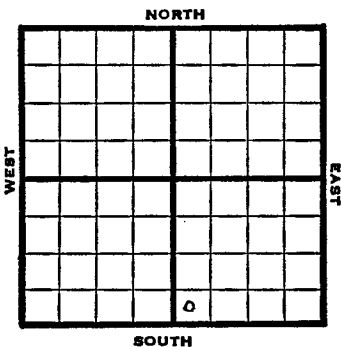

1947 Elev. 1856' REPORT

4/30 8" @ 465'
WOC

5/7 Anhy 625'
Drlg 2713'

5/14 Quartzite 3289'
TD 3310'

ABANDONED

Russell

KANSAS

Section 34 Township 15 Range 11W

Well No. 1 Phillips

Company Herndon Drlg.

Davidson NORTH

