


Russell County Kansas State
 Map No. Sec. 34 Twp. 15 R. 12W
 Well No. 1 Galliart "B"
 J. W. Braden Company
FIRST REPORT Contractor

C N L SE

SECTION PLAT

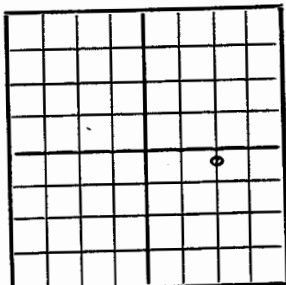

330 Ft. from N. Line

Ft. from S. Line

1320 Ft. from E. Line

Ft. from W. Line

Ney Pool

Remarks:

8" @ 245 Anhy 705 Lans. 2983

Reagan 3311-15 TD 5" @ 3312


Date
AUG 25 1948

Scout S. J. LEWIS

Russell County Kansas State
 Map No. 55 Sec. 34 Twp. 15 R. 11W
 Well No. 1 Phillips "B"
 J. W. Braden Company
CORRECTION Contractor

C N L SE

SECTION PLAT

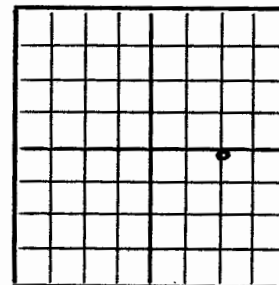

330 Ft. from N. Line

Ft. from S. Line

1320 Ft. from E. Line

Ft. from W. Line

Driscoll Pool

Remarks:

Reported as #1 Galliart "B"
34-15-12WDate
SEP 1 1948


Scout S. J. LEWIS

Russell County Kansas State
 Map No. 55 Sec. 34 Twp. 15 R. 11W
 Well No. 1 Phillips "B"

J. W. Braden Company
ABANDONED

C N L SE Contractor
E. J. 1887
SECTION PLAT

330 Ft. from N. Line
 _____ Ft. from S. Line
1320 Ft. from E. Line
 _____ Ft. from W. Line

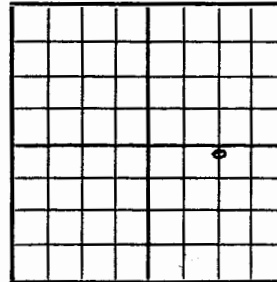

Ney Pool
 Remarks:

Reagan 3811
TD 3361

Date
 SEP 15 1948

Scout S. J. LEWIS

KANSAS Russell

Sec. 34 Twp. 15 R. 12W ^{11W} ✓

Well No. 1 Galliard "B" ^{#1 Phillips "B"} Farm

J.W. Braden Company

Ney Pool


330 Ft. from N. Line

_____ Ft. from S. Line

1320 Ft. from E. Line

_____ Ft. from W. Line

C N L SE

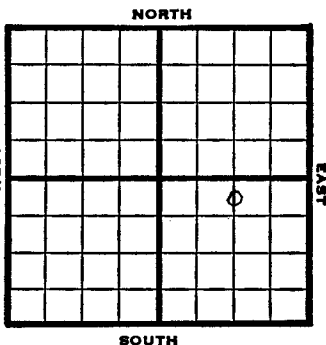

1948 Eli 1859' REPORT

8/25 8" @ 245'
Anhy 705
Lans. 2983'
Reagan 3311-15'
TD 3315'
5" @ 3312
9/1 TD 3315'
9/8 "
9/15 Reagan 3311'
TD 3361'
Aband.

ABANDONED

KANSAS Russell

Section 34 Township 15 Range 12W ^{11W}

Well No. 1 Phillips ^{Galliard "B"}

Company J. W. Braden

Ney Pool

