

Map No. 55 Sec. 34 Twp. 15 R. 11WWell No. 1 PhillipBraden & McClure Company

Contractor

FIRST REPORT

C E L SE NW

Ft. from N. Line

660 Ft. from S. Line330 Ft. from E. Line

Ft. from W. Line

WILDCAT

SECTION PLAT

Location _____

Rig up _____

Drilling and Remarks:

Cellar

RECORD

Cased _____ in., _____ ft.

Sand _____

Gas _____

Oil _____

Total Depth _____

PRODUCTION

1st 24 hrs. Nat. _____

1st 24 hrs. after shot _____

Gas _____ Cu. Ft.

Dry Hole _____

Abandoned _____

Date

OCT 9 1940 19 S. J. LEWIS ScoutMap No. 55 Sec. 34 Twp. 15 R. 11WWell No. 1 PhillipsBraden & McClure Company

CORRECTION _____ Contractor

SECTION PLAT

C N L NW SE

330 Ft. from N. Line

Ft. from S. Line

Ft. from E. Line

660 Ft. from W. Line

WILDCAT

Location _____

Rig up _____

Drilling and Remarks:

Reported

C E L SE NW

RECORD

Cased _____ in., _____ ft.

Sand _____

Gas _____

Oil _____

Total Depth _____

PRODUCTION

1st 24 hrs. Nat. _____

1st 24 hrs. after shot _____

Gas _____ Cu. Ft.

Dry Hole _____

Abandoned _____

Date


OCT 16 1940 19 S. J. LEWIS Scout

Sec. 34 Twp. 15 R. 11-WWell No. #1 Phillip FarmBraden & McClure Company

(Wildcat)

330 Ft. from N. Line660 Ft. from S. Line330 Ft. from E. Line660 Ft. from W. Line

Elev. 1862

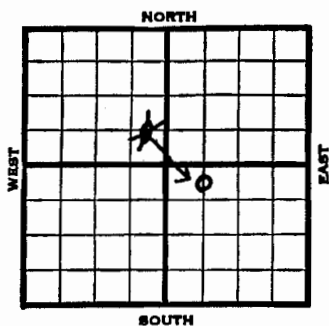

1941

1/15

Gorham 3307'

5" - 3305'

T.D. 3313'

2000 acid.

Potential 1254 bbls., pump.

40. Gravity

COMPLETED

1940	REPORT
10/9	Cellar.
10/17	"
10/24	15" - 410'
	Drlg. 555'
10/31	Anhy 705' 13" - 705'
	Drlg. 1355'
11/7	10" - 1922' Drlg. 2020'
11/14	8" - 2400' Drlg. 2435'
11/21	2610' right hole.
11/27	" " "
12/5	Lens. 2977' 7" - 2977'
	Drlg. 3015'
12/12	Gorham 3307' T.D. 3309'
	400I oil 3 hours.
12/19	T.D. 3313' 5" - 3305'
	2200' oil 10 hours.
12/26	" " "
1941	
1/2	Swab 217 bbls., potential.
1/9	" " " " "
	OVER

Form 26-200 Bks.—1-40—Palace Russell **KANSAS**
Map No. 53 Sec. 34 Twp. 15 R. 11W


Well No. 1 Phillips
Braden & McClure Company

Contractor

COMPLETED

SECTION PLAT

C N L NW SE
330 Ft. from N. Line
Ft. from S. Line
Ft. from E. Line
660 Ft. from W. Line

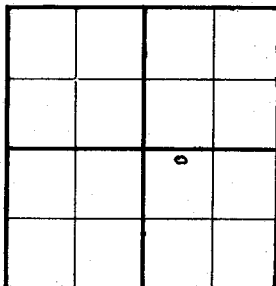

WILDCAT

Location

Rig up

Drilling and Remarks:

Got lam 8307

5' @ 3305'

2000 acid

Pump 1254 Pst

40° Br.

RECORD

Cased _____ in., _____ ft.

Sand _____

Gas _____

Oil _____

Total Depth 8312

PRODUCTION

1st 24 hrs. Nat. _____

1st 24 hrs. after shot _____

Gas _____ Cu. Ft.

Dry Hole _____

Abandoned _____

Date

JAN 15 1941

S. J. LEWIS Scout

KANSAS
Form 51-5M-7-39—Palace

Russell

Section 34 Township 15 Range 11-W

Well No. #1 Phillip

Company Braden & McClure

