

County **Russell** State **Kansas**
 Sec. **35** (Blk. Twp.) **15** (Sur. Rge.) **11W** Map No.
 Operator **Murphy Oil**
 Well No. **1** Farm **Reno** **RENC**
 Elev. _____ Location **NW NE SW**

330 Ft. From **N** Line **SW**
990 Ft. From **E** Line Quarter
 1st. Report **JUN 25 1952**
 Completion _____
 Remarks **Lewis - Contr.**
 Spudding Date **6-20-52**

Drlg. Data

8" @ 317 Anhy 665 Drlg. 1869**J. G. McGEHEE**

County **Russell** State **Kansas**
 Sec. **35** (Blk. Twp.) **15** (Sur. Rge.) **11W** Map No.
 Operator **Murphy Oil**
 Well No. **1** Farm **Reno**
 Elev. **1818** Location **NW NE SW**

330 Ft. From **N** Line **SW**
990 Ft. From **E** Line Quarter
 1st. Report _____
 Completion **JUL 9 1952**
 Remarks **Lewis Drlg. - Contr.**
 Spudding Date **6-20-52**

Drlg. Data **D & A TD 3347****8" @ 317 Anhy 665 Top. 2615****Heeb. 2862 Dodge 2882 Br. lime 2952****Lans. 2969 Arb. 3308 TD 3347****D & A****J. G. McGEHEE**

Russell

KANSAS

Sec. 35 Twp. 15 R. 11W ✓

Well No. #1 Reno RENC Farm

Murphy Oil Company

Lewis Contractor


330 Ft. from N. Line

Ft. from S. Line

990 Ft. from E. Line

Ft. from W. Line

NW NE SW

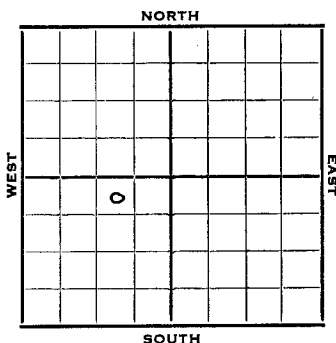

1952 Elev. 1818' REPORT

6/25 Spud 6-20-52
8" @ 317'
Anhy 665'
Drlg. 1869'

7/2 Arb. 3306

7/9 Spud 6-20-52
D & A TD 3347' 8" @ 317'
Anhy 665' Top. 2615' Heeb 2862'
Dodge 2882' Br. line 2952' Lans 2969
Arb. 3308' TD 3347' D & A

ABANDONED

Handwritten calculations:
2969
1416
1551
3308
1818
1490

Russell KANSAS

Section 35 Township 15 Range 11 W

Well No. #1 Reno RENC

Company Murphy Oil

