

Map No. \_\_\_\_\_ Sec. 1 Twp. 15 R. 12WWell No. 1 Smith

Iron Drlg. etal. \_\_\_\_\_ Company

FIRST REPORT \_\_\_\_\_ Contractor

NE SE NE

## SECTION PLAT

\_\_\_\_\_ Ft. from N. Line

990 Ft. from S. Line330 Ft. from E. Line

\_\_\_\_\_ Ft. from W. Line

Russell County

| Location <u>X</u>     | RECORD                       |               |
|-----------------------|------------------------------|---------------|
|                       | Cased                        | in, _____ ft. |
| Rig up _____          | Sand _____                   |               |
| Drilling and Remarks: | Gas _____                    |               |
|                       | Oil _____                    |               |
|                       | Total Depth _____            |               |
|                       | PRODUCTION                   |               |
|                       | 1st 24 hrs. Nat. _____       |               |
|                       | 1st 24 hrs. after shot _____ |               |
|                       | Gas _____                    | Cu. Ft.       |
|                       | Dry Hole _____               |               |
|                       | Abandoned _____              |               |

Date

APR 27 1949

19

S. J. LEWIS

Scout

Map No. K55 Sec. 1 Twp. 15 R. 12WWell No. 1 Smith

Iron Drlg. etal. \_\_\_\_\_ Company

ABANDONED \_\_\_\_\_ Contractor

NE SE NE

## SECTION PLAT

\_\_\_\_\_ Ft. from N. Line

990 Ft. from S. Line330 Ft. from E. Line

\_\_\_\_\_ Ft. from W. Line

Russell County

| Location _____        | RECORD                       |               |
|-----------------------|------------------------------|---------------|
|                       | Cased                        | in, _____ ft. |
| Rig up _____          | Sand _____                   |               |
| Drilling and Remarks: | Gas _____                    |               |
|                       | Oil _____                    |               |
|                       | Total Depth <u>6225</u>      |               |
|                       | PRODUCTION                   |               |
|                       | 1st 24 hrs. Nat. _____       |               |
|                       | 1st 24 hrs. after shot _____ |               |
|                       | Gas _____                    | Cu. Ft.       |
|                       | Dry Hole _____               |               |
|                       | Abandoned _____              |               |

Date

MAY 18 1949

19

S. J. LEWIS

Scout

KANSAS

Russell

Sec. 1 Twp. 15 R. 12W

Well No. #1 Smith Farm

Iron Drlg. et al Company


         Ft. from N. Line

990' Ft. from S. Line

330' Ft. from E. Line

         Ft. from W. Line

NE SE NE

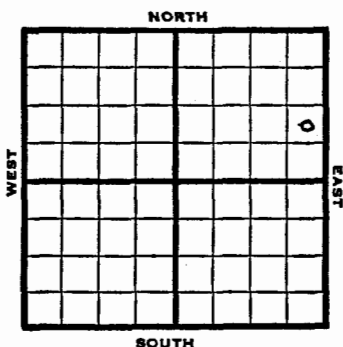

1949 Elev 1793' REPORT

4/27 Location

5/4 "

5/10 8" @ 236  
Drlg 1995'

5/18 TD 3335'  
Lans. 2943'  
Arb. 3310'  
Aband.

**ABANDONED**

KANSAS

Russell

Section 1 Township 15 Range 12W

Well No. 1 Smith

Company Iron Drlg et al

Wildcat

