

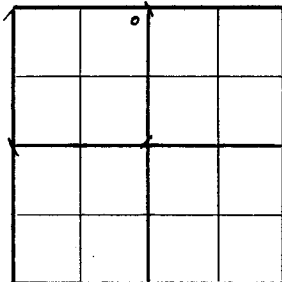
Map No. K-55 Sec. 2 Twp. 15 R. 12WWell No. 1 Ney

Central Petroleum Company

FIRST REPORT Contractor

NE NW

SECTION PLAT

330 Ft. from N. Line

Ft. from S. Line

330 Ft. from E. Line

Ft. from W. Line

GREENVALE POOL

Location

Rig up

Drilling and Remarks:

Cable

RECORD

Cased in, ft.

Sand

Gas

Oil

Total Depth

PRODUCTION

1st 24 hrs. Nat.

1st 24 hrs. after shot

Gas Cu. Ft.

Dry Hole

Abandoned

Date

NOV 19 1941 19 S. J. LEWIS Scout

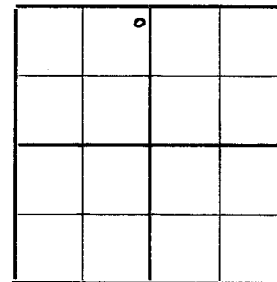
Map No. 55 Sec. 2 Twp. 15 R. 12WWell No. 1 Ney

Central Petroleum Company

ABANDONED Contractor

NE NW

SECTION PLAT

330 Ft. from N. Line

Ft. from S. Line

330 Ft. from E. Line

Ft. from W. Line

GREENVALE POOL

Location

Rig up

Drilling and Remarks:

Ar 8194Water.

RECORD

Cased in, ft.

Sand

Gas

Oil

Total Depth 3214

PRODUCTION

1st 24 hrs. Nat.

1st 24 hrs. after shot

Gas Cu. Ft.

Dry Hole

Abandoned

Date

JAN 7 1942 19 S. J. LEWIS Scout

KANSAS

Russell

Sec. 2 Twp. 15 R. 12-W

Well No. #1 Ney Farm

Central Petr. Company

(Greenvale)

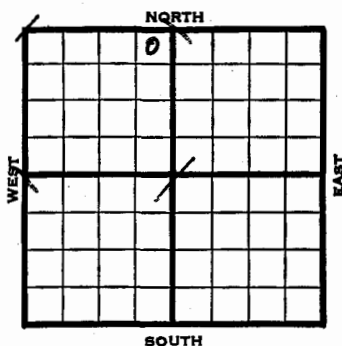
330 Ft. from N. Line

Ft. from S. Line

330 Ft. from E. Line

Ft. from W. Line

Elev. 1671



1941	REPORT
11/19	Cable.
11/26	13" - 330' Drlg. 370'
12/4	10" - 557' Anhy 585'
	Drlg. 1635'
12/11	8" @ 1914 Drlg. 2373
12/18	Topeka 2495
	Dodge 2756
	Drlg. 2790
12/24	Lans. 2840' 7" - 2877'
	T.D. 2980' U.R. 7".
12/31	7" - 2980' Drlg. 3020'
1942	
1/7	Arb. 3194'
	T.D. 3214'
	Water.
	ABANDONED

KANSAS

Russell

Section 2 Township 15 Range 12-W

Well No. #1 Ney

Company Central Petroleum

