

Form 26-200 Bks.-1-40-Palace Russell KANSAS
Map No. 55 Sec. 3 Twp. 15 R. 12W
Well No. 1 Zeman


Cities Service Oil Company

Contractor

~~FIRST REPORT~~

SW NW

SECTION PLAT

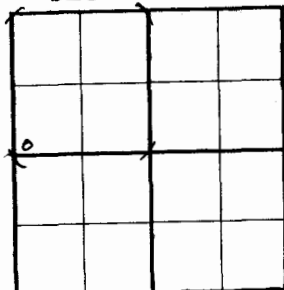

Ft. from N. Line

330 Ft. from S. Line

Ft. from E. Line

330 Ft. from W. Line

GREENVALE POOL

Location X

Rig up

Drilling and Remarks:

RECORD

Cased _____ in., _____ ft.

Sand _____

Gas _____

Oil _____

Total Depth _____

PRODUCTION

1st 24 hrs. Nat. _____

1st 24 hrs. after shot _____

Gas _____ Cu. Ft.

Dry Hole _____

Abandoned _____

Date

AUG 20 1944

S. J. LEWIS Scout

Form 26-200 Bks.-1-40-Palace Russell KANSAS
Map No. K-55 Sec. 3 Twp. 15 R. 12W
Well No. 1 Zeman


Cities Service Oil Company

Contractor

~~COMPLETE~~

SW NW

SECTION PLAT

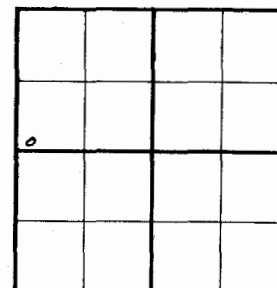

Ft. from N. Line

330 Ft. from S. Line

Ft. from E. Line

330 Ft. from W. Line

GREENVALE POOL

Location _____

Rig up _____

Drilling and Remarks:

Graham 3218

5" @ 3218

Ech 4 2102

Max 3000

38° 42'

RECORD

Cased _____ in., _____ ft.

Sand _____

Gas _____

Oil _____

Total Depth 3250

PRODUCTION

1st 24 hrs. Nat. _____

1st 24 hrs. after shot _____

Gas _____ Cu. Ft.

Dry Hole _____

Abandoned _____

Date

SEP 24 1944 19

S. J. LEWIS Scout

KANSAS

Russell

Sec. 3 Twp. 15 R. 12-WWell No. #1 Zeman FarmCities Service Oil Company
(Greenvale)


Ft. from N. Line

330 Ft. from S. Line

Ft. from E. Line

330 Ft. from W. Line

Elev. 1795

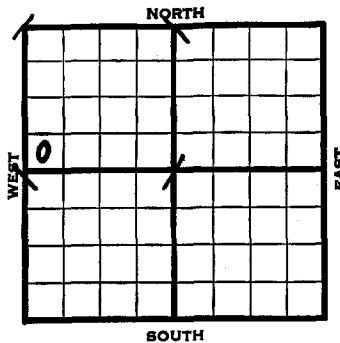

1941	REPORT
8/20	Location
8/28	8" - 312' WOC.
9/4	Drlg. 2310'
9/11	Gorham 3218' 5" - 3219'
	T.D. 3222' RUST.
9/18	T.D. 3250' Echo. test 779 oil.
9/24	Gorham 3218'
	5" - 3219'
	T.D. 3250'
	Echometer potential 3102 bbls.
	Maximum 3000 bbls.
	38. Gravity
	COMPLETED

KANSAS

Russell

Section 3 Township 15 Range 12-WWell No. 1 ZemanCompany Cities service oil

NORTH Greenvale pool

