

Pool Name Hall-GurneyMap No. 55 Sec. 3 Twp. 15 R. 12WWell No. 1 BedigerH. Bendett CompanyFIRST REPORT Contractor


SW NW SE

SECTION PLAT

Ft. from N. Line

330 Ft. from S. Line

Ft. from E. Line

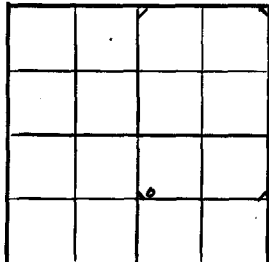330 Ft. from W. LineRussell

Location

Rig up

Drilling and Remarks:

machine

RECORD

Cased in, ft.

Sand

Gas

Oil

Total Depth

PRODUCTION

1st 24 hrs. Nat.

1st 24 hrs. after shot

Gas Cu. Ft.

Dry Hole

Abandoned

Date

NOV 1 1944

19

S. J. LEWIS ScoutPool Name Hall-GurneyKANSAS / ~~Kansas~~ Map No. 55 Sec. 3 Twp. 15 R. 12WWell No. 1 BedigerH. Bendett CompanyCOMPLETED Contractor


SW NW SE

SECTION PLAT

Ft. from N. Line

330 Ft. from S. Line

Ft. from E. Line

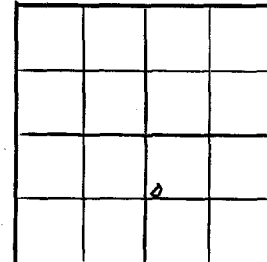330 Ft. from W. LineRussell County

Location

Rig up

Drilling and Remarks:

Line 223?
Gr. hole 3230
5' CS 111

Aug 26 oil 726W
PS

96° 5'

RECORD

Cased in, ft.

Sand

Gas

Oil

Total Depth 3233

PRODUCTION

1st 24 hrs. Nat.

1st 24 hrs. after shot

Gas Cu. Ft.

Dry Hole

Abandoned

Date

JAN 9 1946

19

S. J. LEWIS Scout

KANSAS

Russell County


Sec. 3 Twp. 15 R. 12W

Well No. #1 Badiger Farm

H. Bendett

Company

Hall-Gurney

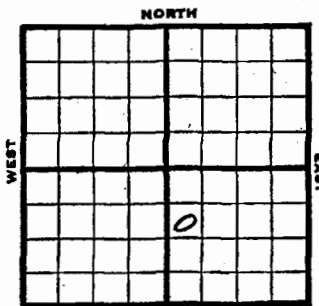

Ft. from N. Line

330

Ft. from S. Line

Ft. from E. Line

330

Ft. from W. Line

SW NW SE

1778 SOUTH

1944

REPORT

11/1 Machine
11/8 "
11/16 "
11/24 "
11/29 "
12/6 15" @ 30'
Drlg. 400I
12/14 Drlg. 400' Shut down
12/21 SD
12/29 "
1945
1/3 "
1/10 "
1/17 15" @ 305 SD
1/26 " " " "
1/31 " " " "
2/7 " " " "
2/14 " " " "
2/21 10" @ 392
Drlg 684 SD
2/28 " " "
3/7 684 UR 10"
3/14 10" @ 683
Drlg 1550
3/23 Drlg. 1985'
3/29 No report

OVER

1945

4/5 8" @ 2165
Drlg. 2395'

4/12 8" @ 2393
Drlg. 2545

4/20 7" @ 2950'
Lans 2950

WOC

4/27 TD 3036
1 bailer oil per hr

5/3 " " " " "

5/10 1300' oil in two days

5/17 5000 acid. Wtr.

PB 3019

5/24 TD 3036 5000 acid.

5/31 Pump 19 oil plus 19 wtr. in 24 hrs.

6/8 " " " "

~~6/14~~ " " " "

6/21 " " " "

6/28 " " " "

7/3 " " " "

7/11 " " " "

7/19 " " " "

7/26 " " " "

8/1 " " " "

8/8 Drlg. 3083

8/15 Cong. 3210

Drlg. 3225

8/22 Gorham 3230

TD 3253

HFW Run 5"

8/29 Shut down

9/5 " "

9/12 " "

9/19 " "

9/26 " "

10/3 " "

10/10 " "

10/17 " "

10/24 5" @ 3111

24 shots 3019-3030 500' Wtr. 12 hrs.

PB 3085'

10/31 " " " " "

11/7 " " " " "

11/14 " " " " "

OVER

1945

11/21 5" @ 3111'
24 shots 3019-3030 500' wtr. 12 hrs.
PB 3085'

11/28 " " " " "
12/5 " " " " "
12/12 " " " " "
12/20 " " " " "
12/29 " " " " "

1946

1/9 Lans. 2937
Gorham 3230
5" @ 3111
TD 3253'
Pump 26 oil plus 26 wtr. Pot.
Grav. 36.0

COMPLETED

FORM 51 5M BRIX


KANSAS

Russell County

Section 3 Township 15 Range 12W

Well No. #1 Bediger

Company H. Bendett

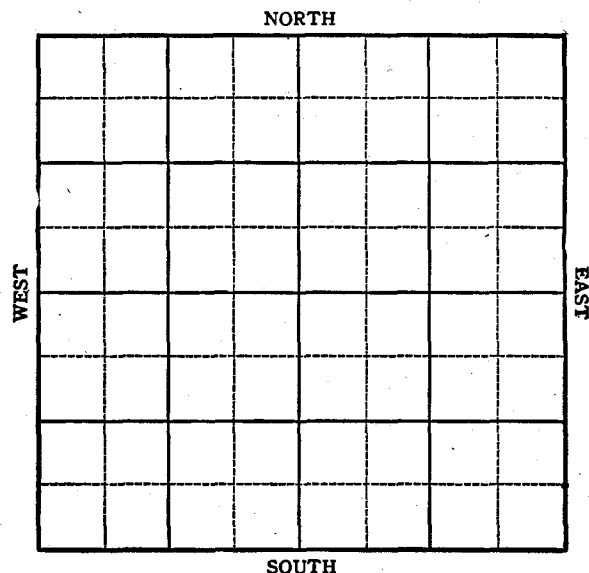

Steinke-Prediger 1
Brunson Drilling Co.