

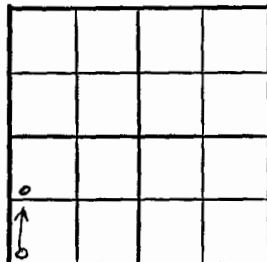
Map No. 5 Sec. 3 Twp. 15 R. 12WWell No. 6 Soukup

Phil-Han Company

CORRECTION Contractor

SW NW SW

SECTION PLAT

990 Ft. from N. Line Ft. from S. Line Ft. from E. Line330 Ft. from W. Line

Russell County

Location

Rig up

Drilling and Remarks:

Reported SW/C

RECORD

Cased in., ft.

Sand

Gas

Oil

Total Depth

PRODUCTION

1st 24 hrs. Nat.

1st 24 hrs. after shot

Gas Cu. Ft.

Dry Hole

Abandoned

Date

JAN 22 1947 19 S. J. LEWIS Scout

Kansas

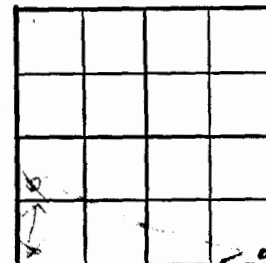
Map No. 5 Sec. 3 Twp. 15 R. 12WWell No. 6 Soukup

Phil-Han etal. Company

CORRECTION Contractor

SW/C

SECTION PLAT

 Ft. from N. Line330 Ft. from S. Line Ft. from E. Line330 Ft. from W. Line

Russell County

Location

Rig up

Drilling and Remarks:

Reported
Harry Gore

RECORD

Cased in., ft.

Sand

Gas

Oil

Total Depth

PRODUCTION

1st 24 hrs. Nat.

1st 24 hrs. after shot

Gas Cu. Ft.

Dry Hole

Abandoned

Date

JAN 15 1947 19 S. J. LEWIS Scout

Russell County

Sec. 3 Twp. 15 R. 12W

Well No. 6 Soukup Farm

Harry Gore Phil-Ham et al Company

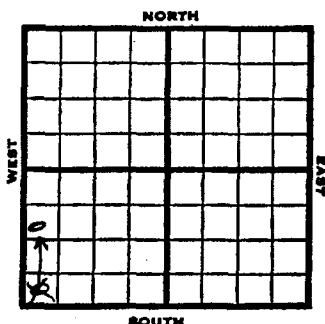
Hall-Gurney

Ft. from N. Line

330 Ft. from S. Line

Ft. from E. Line

330 Ft. from W. Line



SW/4 SW NW SW

1947 1285 REPORT

1/2 Location
1/8 "
1/15 "
1/21 RUR
1/30 8" @ 460'
Drlg 470'
2/5 Anhydrite 722'
Drlg 1195'
2/12 2040 Run 8"
2/19 2275 W R 8"
2/26 Drlg 2485'
3/4 Lans 2969
7" @ 2958'
TD 3005'
3/12 TD 3055'
700' oil in 2½ hrs

Over

3/26

Lans. 3969'
7" @ 2958'
5" Perf. liner @ 3060'
10000 acid
Pump 250 oil & 40% w/Pot
39.9 Gr.
TD 3060

COMPLETED

Hall-Gurney

Kansas

Map No. 135 Sec. 3 Twp. 15 R. 12WWell No. 6 Soukup

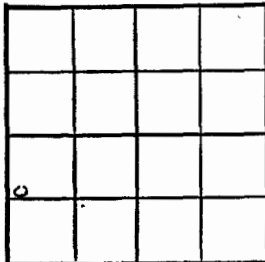
Phil-Han et al. Company

COMPLETE

Contractor

SW NW SW

SECTION PLAT

990 Ft. from N. Line Ft. from S. Line Ft. from E. Line330 Ft. from W. Line

Russell County

Location

Rig up

Drilling and Remarks:

Lane 29697°02'25"5 Prof liner @ 20601000 acidPump 250 oil +45% N.P.T.2924

RECORD

Cased in., ft.Sand Gas Oil Total Depth 2060

PRODUCTION

1st 24 hrs. Nat. 1st 24 hrs. after shot Gas Cu. Ft.Dry Hole Abandoned

Date

MAR 26 1947

19

S. J. LEWIS

Scout

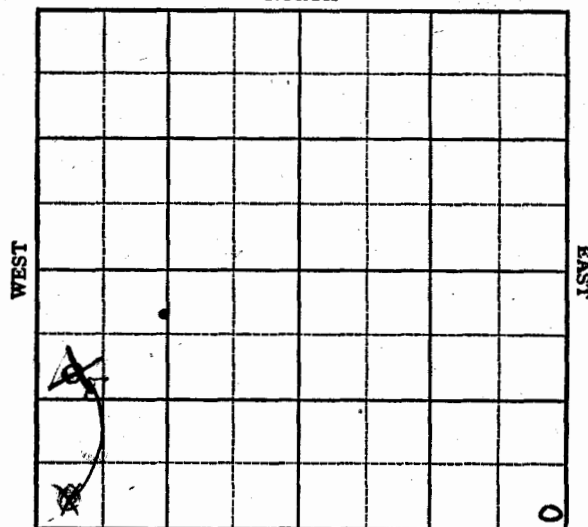
KANSAS

FORM 51 10M 12-46 PETROL

Russell county

Section 3 Township 15 Range 12WWell No. #6, SoukupCompany Harry Gore Phil-Han

NORTH



SOUTH