

Map No. 11-55 Sec. 3 Twp. 15 R. 12W


Well No. 2 Soukup

Phil-Hal Company

FIRST REPORT Contractor

SECTION PLAT

C NL NW SW
330 Ft. from N. Line
Ft. from S. Line
Ft. from E. Line
660 Ft. from W. Line

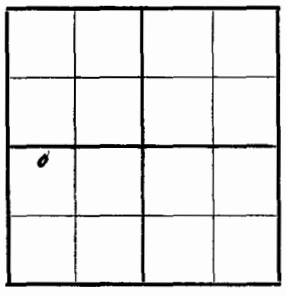

GREENVALE POOL

Location _____

Rig up _____

Drilling and Remarks:

Cable

RECORD

Cased _____ in., _____ ft.

Sand _____

Gas _____

Oil _____

Total Depth _____

PRODUCTION

1st 24 hrs. Nat. _____

1st 24 hrs. after shot _____

Gas _____ Cu. Ft.

Dry Hole _____

Abandoned _____

Date
OCT 8 1941 19

S. J. LEWIS Scout

Map No. 55 Sec. 3 Twp. 15 R. 12W


Well No. 2 Soukup

Phil-Hal Company

COMPLETED Contractor

SECTION PLAT

C NL NW SW
330 Ft. from N. Line
Ft. from S. Line
Ft. from E. Line
660 Ft. from W. Line

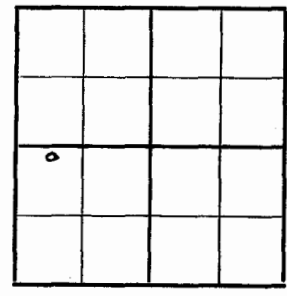

GREENVALE POOL

Location _____

Rig up _____

Drilling and Remarks:


RECORD

Cased _____ in., _____ ft.

Sand _____

Gas _____

Oil _____

Total Depth 324 1/2

PRODUCTION

1st 24 hrs. Nat. _____

1st 24 hrs. after shot _____

Gas _____ Cu. Ft.

Dry Hole _____

Abandoned _____

Date
DEC 23 1941 19

S. J. LEWIS Scout

Sec. 3 Twp. 15 R. 12-W

Well No. #2 Soukup Farm

Phil-Hal Company

(Greenville)


330 Ft. from N. Line

_____ Ft. from S. Line

_____ Ft. from E. Line

660 Ft. from W. Line

Elev. 1792

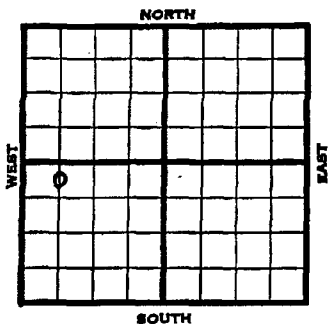

1941
12/23

Lans. 2939'
6" - 2961'
Gorham 3220'
5" liner 3221'
T.D. 3242'
Potential 856 bbls., pump.
39. Gravity

COMPLETED

1941	REPORT
10/8	Cable.
10/16	12" - 395' Drlg. 400'
10/23	Drlg. 1400'
10/30	any 670' 10" - 682'
	8" - 2001' Drlg. 2100'
11/6	8" - 2341' Drlg. 2480'
11/13	Lans. 2939' 6" - 2961'
	Pay 3020-25' 1500' oil.
	Drlg. 3035'
11/20	T.D. 3063' 6" - 3063'
	Drlg. 3135'
11/26	Gorham 3220' T.D. 3221'
	300' oil in 10 hours.
	5" liner at 3221' WOC.
12/4	T.D. 3231' 2000' oil 4 hours.
12/11	Pump 126 oil in 16 hrs. Drlg. 3237.
12/18	TD 3242 SD
	OVER

KANSAS

Russell

FORM 51 5M 4-41 PETROL

Section 3 Township 15 Range 12-W

Well No. 2 Soukup

Company Phil-Hal

NORTH Greenvale pool

