

Map No. 55 Sec. 3 Twp. 15 R. 12W

Well No. 1 Soukup

Phil-Han Company

Contractor

FIRST REPORT

SECTION PLAT

NW SW

330 Ft. from N. Line

_____ Ft. from S. Line

_____ Ft. from E. Line

330 Ft. from W. Line

GREENVALE POOL

o			

Location _____

RECORD

Cased _____ in., _____ ft.

Sand _____

Gas _____

Oil _____

Total Depth _____

PRODUCTION

1st 24 hrs. Nat. _____

1st 24 hrs. after shot _____

Gas _____ Cu. Ft.

Dry Hole _____

Abandoned _____

Rig up _____

Drilling and Remarks:
Rotary

Date _____

S. J. LEWIS Scout

APR 16 1941 19

Map No. 55 Sec. 3 Twp. 15 R. 12W

Well No. 1 Soukup

Phil-Han Company

Contractor

COMPLETED

SECTION PLAT

NW SW

330 Ft. from N. Line

_____ Ft. from S. Line

_____ Ft. from E. Line

330 Ft. from W. Line

GREENVALE POOL

o			

Location _____

RECORD

Cased _____ in., _____ ft.

Sand _____

Gas _____

Oil _____

Total Depth 303 1/2

PRODUCTION

1st 24 hrs. Nat. _____

1st 24 hrs. after shot _____

Gas _____ Cu. Ft.

Dry Hole _____

Abandoned _____

Rig up _____

Drilling and Remarks:
Land 2962
7" @ 2963
78' x 5" Perforated
Water 303 1/2
1000 acid
Flow 920 ft
396 lb

Date _____

S. J. LEWIS Scout

JUN 4 1941 19

KANSAS
Russell


FORM 51 5M 4-41 PETROL

Section 3 Township 15 Range 12-W

Well No. #1 Soukup

Company Phil-Han

NORTH **Greenvale Pool**

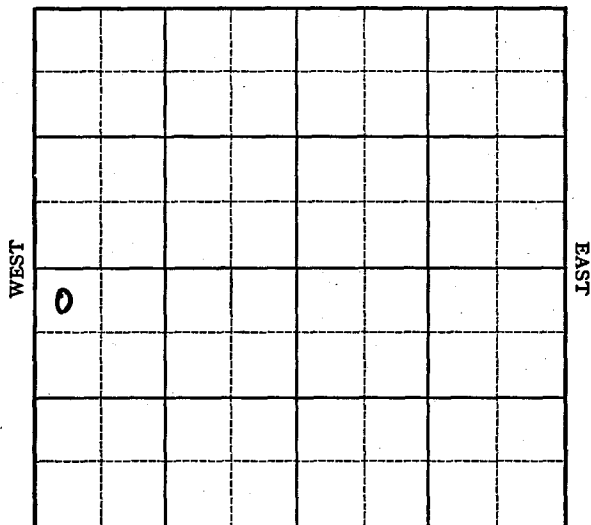

SOUTH