

Russell

Map No. 55 Sec. 4 Twp. 15 R. 12WWell No. 3 Major

Stanolind Company

FIRST REPORT Contractor

C SL NE NE


SECTION PLAT

990 Ft. from N. Line

Ft. from S. Line

660 Ft. from E. Line

Ft. from W. Line

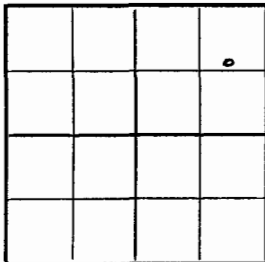

GREENVALE POOL

Location _____
 Rig up _____
 Drilling and Remarks:

Derrick

RECORD

Cased _____ in., _____ ft.
 Sand _____
 Gas _____
 Oil _____
 Total Depth _____

PRODUCTION

1st 24 hrs. Nat. _____
 1st 24 hrs. after shot _____
 Gas _____ Cu. Ft.
 Dry Hole _____
 Abandoned _____

Date

MAR 24 1943 19

S. J. LEWIS Scout

Russell

Map No. 55 Sec. 4 Twp. 15 R. 12WWell No. 3 Major

Stanolind Company

COMPLETED Contractor

C SL NE NE


SECTION PLAT

990 Ft. from N. Line

Ft. from S. Line

660 Ft. from E. Line

Ft. from W. Line

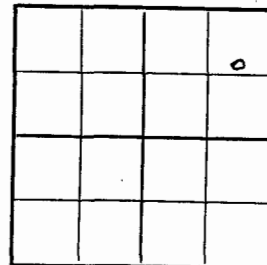

GREENVALE POOL

Location _____
 Rig up _____
 Drilling and Remarks:

Lane 2905
Sooy Sol 3194
6 63195
Prof. Lane
500000 oil
Pump 450 nit
74 1/2 B&N.

Date 385 *gr*

MAY 12 1943 19

S. J. LEWIS Scout

RECORD

Cased _____ in., _____ ft.
 Sand _____
 Gas _____
 Oil _____
 Total Depth 6210

PRODUCTION


1st 24 hrs. Nat. _____
 1st 24 hrs. after shot _____
 Gas _____ Cu. Ft.
 Dry Hole _____
 Abandoned _____

KANSAS

Russell

Sec. 4 Twp. 15 R. 12-WWell No. #3 Major FarmStanolind Company

Greenvale

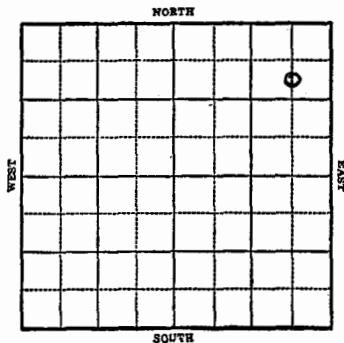990 Ft. from N. Line Ft. from S. Line660 Ft. from E. Line Ft. from W. LineElev. 1765

1943

REPORT

3/24 Derrick
3/31 "
4/7 13" @ 519'
Drlg. 1550
4/14 Anhy 665'
Drlg. 2447'
4/21 Lans 2905
SSO 2909-11
Drlg. 3095'
4/28 Soog sand 3194
T. D. 3210 SD
6" @ 3195 RUST.
5/5 36 shots 2919-32
48 " 2993 $\frac{1}{2}$ -3003 $\frac{1}{2}$
5000 acid swab 88 oil in 12 hrs.
5/12 Lans 2905
Soog. sd. 3194
6" @ 3195'
T.D. 3210'
Perf. Lans.
5000 gal. acid
Pump 450 oil plus 14% BS & W.
Gravity 38.5

COMPLETED

KANSAS

Russell

Section 4 Township 15 Range 12-WWell No. #3 MajorCompany Stanolind