

Russell

KANSAS

Map No. 55 Sec. 4 Twp. 15 R. 12WWell No. 4 Major

Jones & Shelborne Company

FIRST REPORT Contractor

NE SW NE


Ft. from N. Line

990 Ft. from S. Line

Ft. from E. Line

990 Ft. from W. Line

SECTION PLAT

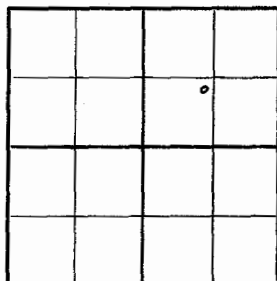

GREENVALE POOL

Location

Rig up

Drilling and Remarks:

13" - 375

Anhy. 642

10" - 648

Drlg. 1410

RECORD

Cased in, ft.

Sand

Gas

Oil

Total Depth

PRODUCTION

1st 24 hrs. Nat.

1st 24 hrs. after shot

Gas Cu. Ft.

Dry Hole

Abandoned

Date

AUG 1 2 1942

19

S. J. LEWIS Scout

Russell

KANSAS

Map No. 55 Sec. 4 Twp. 15 R. 12WWell No. 4 Major

Jones & Shelborne Company

COMPLETED Contractor

NE SW NE


Ft. from N. Line

990 Ft. from S. Line

Ft. from E. Line

990 Ft. from W. Line

SECTION PLAT

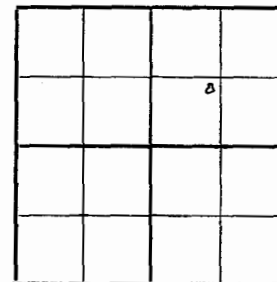

GREENVALE POOL

Location

Rig up

Drilling and Remarks:

Lano 63183

7" 03175.

Pump 522 P.T.

394 gr

RECORD

Cased in, ft.

Sand

Gas

Oil

Total Depth 3202

PRODUCTION

1st 24 hrs. Nat.

1st 24 hrs. after shot

Gas Cu. Ft.

Dry Hole

Abandoned

Date

SEP 2 3 1942

19

S. J. LEWIS Scout

KANSAS Russell

Sec. 4 Twp. 15 R. 12-W

Well No. #4 Major Farm

Jones & Shelborne Company

(Greenvale Pool)


Ft. from N. Line

990 Ft. from S. Line

Ft. from E. Line

990 Ft. from W. Line

Elev. 1754

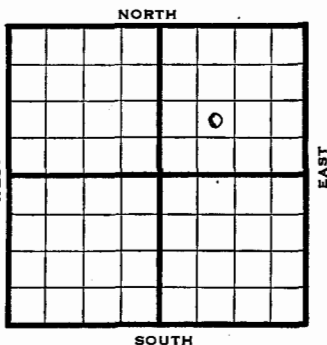

REPORT

1942	REPORT
8/12	13" - 375' Anhy. 642 10" - 648 Drlg. 1410'
8/19	8" - 1935 Drlg. 2160'
8/27	2544 WR 8"
9/2	8" - 2525 Drlg. 2580'
9/9	Lans 2882 Drlg 2990
9/16	7" @ 3175 Sand 3183 TD 3203 600' oil
9/23	Sand 3183 7" 3175 TD 3203 Pump 522 Pot. 39.4 Gr

COMPLETED

KANSAS

Russell

FORM 51 5M 10-41 PETROL

Section 4 Township 15 Range 12-W

Well No. #4 Major

Company Jones & Shelborne

Greenvale Pool NORTH

