

Map No. _____ Sec. 4 Twp. 15 R. 12WWell No. 1 Major

Stanolind _____ Company

Contractor

FIRST REPORT

SE NE


_____ Ft. from N. Line

330 Ft. from S. Line330 Ft. from E. Line

_____ Ft. from W. Line

Greenvale Pool

SECTION PLAT

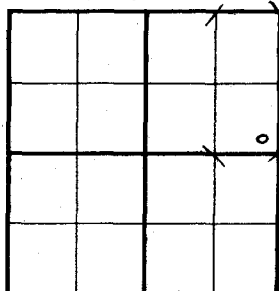

Location _____

Rig up _____

Drilling and Remarks:

Derrick

RECORD

Cased _____ in., _____ ft.

Sand _____

Gas _____

Oil _____

Total Depth _____

PRODUCTION

1st 24 hrs. Nat. _____

1st 24 hrs. after shot _____

Gas _____ Cu. Ft.

Dry Hole _____

Abandoned _____

Date

JUN 4 1941 19 S. J. LEWIS Scout

Map No. 55 Sec. 4 Twp. 15 R. 12WWell No. 1 Major

Stanolind _____ Company

Contractor

COMPLETED

SE NE


_____ Ft. from N. Line

330 Ft. from S. Line330 Ft. from E. Line

_____ Ft. from W. Line

GREENVALE POOL

SECTION PLAT

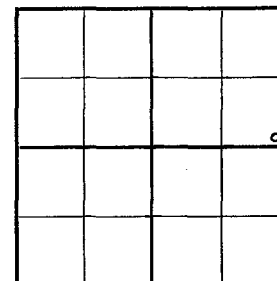

Location _____

Rig up _____

Drilling and Remarks:

*Good hole 3234**7' 3238**Depth 3516**May 3000**380 Gr.*

RECORD

Cased _____ in., _____ ft.

Sand _____

Gas _____

Oil _____

Total Depth 3257

PRODUCTION

1st 24 hrs. Nat. _____

1st 24 hrs. after shot _____

Gas _____ Cu. Ft.

Dry Hole _____

Abandoned _____

Date

AUG 20 1941 19 S. J. LEWIS Scout

O. W. P. B. KANSAS Russell

Sec. 4 Twp. 15 R. 12-W

Well No. #1 Major Farm
Stanolind Company

(Greenville)


Ft. from N. Line

330 Ft. from S. Line

330 Ft. from E. Line

Ft. from W. Line

Elev. 1805

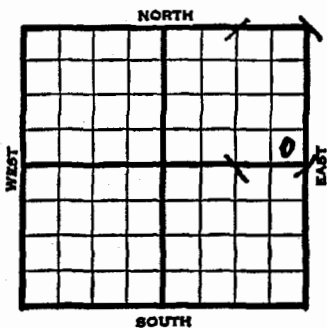

1941	REPORT
6/4	Derrick.
6/12	"
6/19	15" - 291' Drlg. 390'
6/26	13" - 531' Drlg. 970'
7/3	Anhy 696' 10" - 701'
	Drlg. 1615'
7/10	2225' U.R. 8".
7/17	Topeka 2595' 8" - 2280'
	Drlg. 2655'
7/24	Dansing 2948 7" @ 2955 TD 3052-1425'
	oil in 20 hrs.
7/31	7" @ 3053 Drlg. 3162'
8/7	Sooy 3234' 7" @ 3234 TD 3257
	2400g oil 1 hr.
8/15	Swab 50 bbls oil per hr
	no water 2000' off bottom
	7" 3236'
	OVER

1941
8/20

Sooy Sand 3234'
7" - 3236'
T.D. 3257'
Depthograph potential 3516 bbls.
Maximum 3000 bbls.
38. Gravity


COMPLETED

1951
7/11

O. W. P. B.
Lans. 2962' Cong 3234' OTD 3257'
7" @ 3236' was Cong prod. PB 3200'
16/3034-39' 12/3042-45'
36/3052-61' P/9 BO plus 12 BWPD
in Lans.

FIRST REPORT
✓
COMPLETED

County Russell State Kansas
 Sec. 4 (Bk. 15 (Sur. 12W Map No.
 Operator Stanolind
 Well No. 1 Farm Major
 Elev. 1805 Location SE SE NE

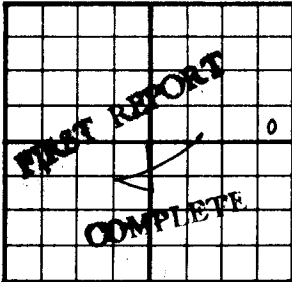

330 Ft. From 8 Line NE
330 Ft. From 8 Line Quarter
 Ist. Report JUL 11 1951
 Completion JUL 11 1951
 Remarks OWPB
O. W. P. B.
 Spudding Date

Drig. Data

Lans 2862 Cong. 3234 O.T.D. 3257 7" @ 3256
 was cong prod. P.B. 3200, 16/3054-59
 12/3042-45, 36/3052-61 P/B DO plus 12
 BWPD, in Lans. Complete

J. E. TYRA

KANSAS

FORM 51 5M 4-41 PETROL

Russell

O. W. P. B.

Section 4 Township 15 Range 12WWell No. 1 MajorCompany Stanolind