Form 26—200 Bks.—1-48—Palace

Kansas

Hall-Gurney Pool

Map No. _____ Sec. 4 Twp. 15 R. 12W

Well No. 4 Kuhnle

Eldorado Ref. Company

FIRST REPORT Contractor

C S L NE NW


990 Ft. from N. Line

_____ Ft. from S. Line

560 Ft. from E. Line

_____ Ft. from W. Line

SECTION PLAT

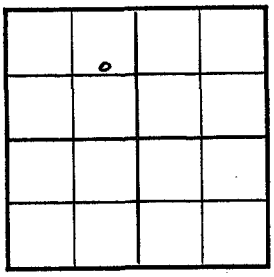

Russell County

Location _____

Rig up _____

Drilling and Remarks:

twin well

Anhy 665

8" @ 671

drlg. 3018

RECORD

Cased _____ in., _____ ft.

Sand _____

Gas _____

Oil _____

Total Depth _____

PRODUCTION

1st 24 hrs. Nat. _____

1st 24 hrs. after shot _____

Gas _____ Cu. Ft.

Dry Hole _____

Abandoned _____

Date

MAY 19 1948 19____ S. J. LEWIS Scout

Form 26—200 Bks.—1-48—Palace

Kansas

Hall-Gurney Pool

Map No. 55 Sec. 4 Twp. 15 R. 12W

Well No. 4 Kuhnle

Eldorado Ref. Company

COMPLETE Contractor

EL1767

C S L NE NW


990 Ft. from N. Line

_____ Ft. from S. Line

560 Ft. from E. Line

_____ Ft. from W. Line

SECTION PLAT

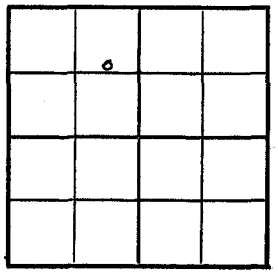

Russell County

Location _____

Rig up _____

Drilling and Remarks:

Lans 2932

Gorham 3204

5" C 3204

Pump 100 oil 5 bbls wtr

40-8 Gr

RECORD

Cased _____ in., _____ ft.

Sand _____

Gas _____

Oil ✓

Total Depth 3208

PRODUCTION

1st 24 hrs. Nat. _____

1st 24 hrs. after shot _____

Gas _____ Cu. Ft.

Dry Hole _____

Abandoned _____

Date

JUN 16 1948 19____ S. J. LEWIS Scout

FORM 252-A
5M 4-48 PETROL KANSAS Russell ✓

Sec. 4 Twp. 15 R. 12W

Well No. #4 Kuhnle Farm

Eldorado Ref. Company

Hall-Gurney Pool


990' Ft. from N. Line

_____ Ft. from S. Line

560' Ft. from E. Line

_____ Ft. from W. Line

C S L NE NW

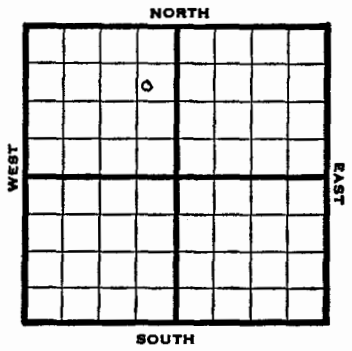

1948	REPORT
	Elev 1767'
5/19	Twin Well Anhy 665' 8" @ 671' Drlg. 3016'
5/26	Lansing 2932' Gorham 3204' TD 3208' 5" @ 3204' 2200' oil 19 hrs.
6/1	"
6/9	"
6/16	TD 3208' Lansing 2932' Gorham 3204' 5"@ 3204' Pump 100 oil Pot 40^{9} Gr. Comp. COMPLETED

FORM 51 10M 8-47 KANSAS Russell

Section 4 Township 15 Range 12W

Well No. #4 Kuhnle

Company Eldorado Ref.

