

Map No. 55 Sec. 4 Twp. 15 R. 12WWell No. 1 Kuhnle

Eldorado Refining Company

Contractor

FIRST REPORT

C S L NE NW

990 Ft. from N. Line

Ft. from S. Line

660 Ft. from E. Line

Ft. from W. Line

GREENVALE POOL

SECTION PLAT

	o		

Location

RECORD

Cased in. ft.

Sand

Gas

Oil

Total Depth

PRODUCTION

1st 24 hrs. Nat.

1st 24 hrs. after shot

Gas Cu. Ft.

Dry Hole

Abandoned

Date

APR 10 1940 19

S. J. LEWIS Scout

Map No. 55 Sec. 4 Twp. 15 R. 12WWell No. 1 Kuhnle

Eldorado Refining Company

Contractor

COMPLETED

C S L NE NW

990 Ft. from N. Line

Ft. from S. Line

660 Ft. from E. Line

Ft. from W. Line

GREENVALE POOL

SECTION PLAT

	o		

Location

RECORD

Cased in. ft.

Sand

Gas

Oil

Total Depth 3212

PRODUCTION

1st 24 hrs. Nat.

1st 24 hrs. after shot

Gas Cu. Ft.

Dry Hole

Abandoned

Date

JUN 12 1940 19

S. J. LEWIS Scout

KANSAS

Russell

Sec. 4 Twp. 15 R. 12-WWell No. #1 Kuhnle FarmEldorado Refg. Company

(Greenvale)


990 Ft. from N. Line

Ft. from S. Line

660 Ft. from E. Line

Ft. from W. Line

Elev. 1764

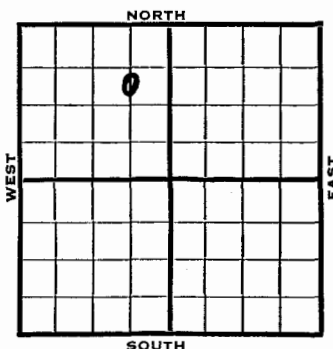

1940	REPORT
4/10	Bldg. cable rig.
4/18	" " "
4/25	Drlg. 871'
5/2	20" - 91' Drlg. 385'
5/9	15" - 386' 13" - 672'
	Drlg. 1295'
5/16	Anhy 662' 10" - 1966'
	Drlg. 2100'
5/23	8" - 2580' Drlg. 2650'
5/29	Dodge 2850' Lans. 2917'
	Cong. 3195' Gorham 3206'
	S.O. 3208' Run 7".
6/6	7" - 3205' T.D. 3212'
	2700' oil.
6/12	Gorham 3206'
	7" - 3205'
	T.D. 3212'
	Potential 583 bbls., pump.
	COMPLETED

KANSAS

Form 51-5M-7-39-Palace

Russell

Section 4 Township 15 Range 12-WWell No. #1 KuhnleCompany Eldorado Refining